

KANSAS Kansas Pool Name Wildcat
Map No. 74 Sec. 21 Twp. 16 R. 17W
Well No. 1 Urban

KANSAS Kansas Pool Name Wildcat
Map No. 74 Sec. 21 Twp. 16 R. 17W
Well No. 1 Urban

Eldorado Ref. Company

Eldorado Ref. Company

FIRST REPORT Contractor

COMPLETED Contractor

NW NE NW

SECTION PLAT

330 Ft. from N. Line
____ Ft. from S. Line
990 Ft. from E. Line
990 Ft. from W. Line

	o		

Rush County

NW NE NW

E11927
SECTION PLAT

330 Ft. from N. Line
____ Ft. from S. Line
____ Ft. from E. Line
990 Ft. from W. Line

	o		

Rush County

Location X

RECORD

Rig up _____

Drilling and Remarks:

Cased _____ in., _____ ft.
Sand _____
Gas _____
Oil _____
Total Depth _____

PRODUCTION

1st 24 hrs. Nat. _____
1st 24 hrs. after shot _____
Gas _____ Cu. Ft.
Dry Hole _____
Abandoned _____

Date

JUL 18 1945 19 S. J. LEWIS Scout

Location _____

RECORD

Rig up _____

Drilling and Remarks:

Art 3521
5' 08023
PB3537
1,300,000 Gas
7.7 Helium

Cased _____ in., _____ ft.
Sand _____
Gas _____
Oil _____
Total Depth 3578

PRODUCTION

1st 24 hrs. Nat. _____
1st 24 hrs. after shot _____
Gas _____ Cu. Ft.
Dry Hole _____
Abandoned _____

Date

NOV 21 1945 19 S. J. LEWIS Scout

KANSAS Rush

Sec. 21 Twp. 16 R. 17-W

Well No. #1 Urban Farm


Eldorado Ref. Company

330 Ft. from N. Line

_____ Ft. from S. Line

990 Ft. from E. Line

~~990~~ Ft. from W. Line

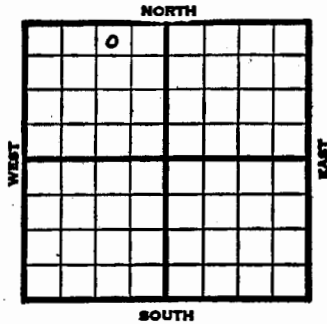

NW NE SW Elev. 1977

REPORT

1945	
7/18	Location
7/26	13" @ 35'
	Drlg. 137
8/1	Drlg. 2000'
8/8	8" @ 1116
	Drlg. 3105
8/15	Lens 3260
	Arb. 3521-3526
	TD 3526
	Ruj 5"
8/22	Cong 3495
	5" @ 3523
8/29	TD 3535
	3 M Gas
8/5	TD 3548 SW
	PB 3537
9/12	3 M Gas S.D.
9/19	" " "
9/26	" " "
10/3	" " "
10/10	" " "
10/17	" " "
10/24	" " "
10/31	" " "
11/7	" " "
11/14	" " "

OVER

1945

11/21 Arb. 3521
5" @ 3523
PB 3537
TD 3548
1,300,000 Gas.
1.7 Helium

COMPLETED

KANSAS Rush

FORM 51 5M PETROL

Section 21 Township 16 Range 17W

Well No. 1 Urban

Company Eldorado Ref.

