



Rush

KANSAS

SEC.	TWP.	R.
25	16	17W


WELL NO. **#1 Sherwood** FARM

COMPANY **Loffland Bros.**

CONTRACTOR

**Wildcat.**

\_\_\_\_\_ Ft. from N. Line  
**330** \_\_\_\_\_ Ft. from S. Line  
 \_\_\_\_\_ Ft. from E. Line  
**330** \_\_\_\_\_ Ft. from W. Line

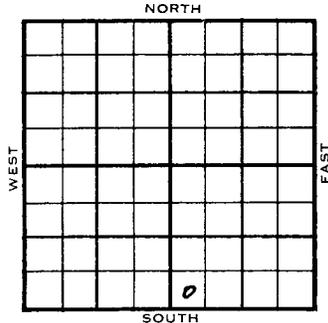

SW SW SE

**Sinc. Gt. Lakes & Carter - support.**

1954	ELEVATION	REPORT
	1989'	
11/23	M I R	
12/15	Spud 11-28-54 D & A TD 3600' 8-5/8" @ 1109' Anhy 1110', Top 2990', Heeb 3230' Tor. 3249' Doug 3265' Lans 3280' DST 3340'-80' opn 1 hr, rec 305' Mud 750# Cong 3535' Arb. 3573'-82' DST 3575'-82' opn 1 hr, rec 270' wtry mud, 1006' s.w. 630# TD 3600' Lo g Tops: Heeb 3229', Tor 3245' Lans 3282' Cong 3531', Re-Arb. 3542' Arb. 3553' D & A	
		<b>ABANDONED</b>

DX-78

Rush

KANSAS

DX 78-1

Section **25** Township **16** Range **17W**

Well No. **#1 Sherwood**

Company **Loffland Bros.**

