


County **Rush** State **Kansas**

Sec. **27** (Blk. Twp.) **16** (Sur. Rge.) **17W** Map No.

Operator **Fleming & Woodman**

Well No. **1** Farm **Holzmeister**

Elev. Location **NE NE NW**

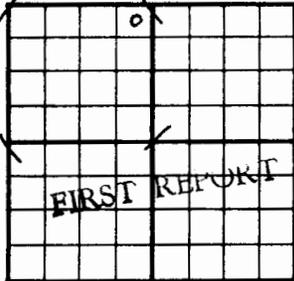

**330** Ft. From **N** Line **NW**

**330** Ft. From **E** Line Quarter

Ist. Report **DEC 1 1954**

Completion

Remarks **Sun. Sunray & Shell - DHM**

**Brack Drlg. - Contr.**

Spudding Date

Drlg. Data **Wildcat**

**M I R**

FABEN GILSTRAP


County **Rush** State **Kansas**

Sec. **27** (Blk. Twp.) **16** (Sur. Rge.) **17W** Map No.

Operator **Fleming & Woodman**

Well No. **1** Farm **Holzmeister**

Elev. **2045** Location **NE NE NW**

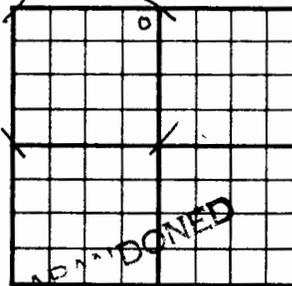

**330** Ft. From **N** Line **NW**

**330** Ft. From **E** Line Quarter

Ist. Report

Completion **DEC 15 1954**

Remarks **Wildcat**

**Brack Drlg. - Contr.**

Spudding Date **11-30-54**

Drlg. Data **D & A TD 3650**

**Anhy 1160 8 5/8" @ 1171 Heeb. 3284**

**Tor. 3302 Lans. 3334 DST 3351-3413**

**open 1 hr. Rec. 250' gas 50' so & gom  
120' muddy gassy sw 240' sw 990#**

**DST 3568-93 open 1 hr. Rec. 15' mud  
1' hvy blk. oil 0# Arb. 3601**

**DST 3604-18 open 1 hr. Rec. 260' sw**

**500# TD 3650**

**D & A**

FABEN GILSTRAP

Rush

KANSAS

SEC.	TWP.	R.
27	16	17W

WELL NO. #1 Holzmeister FARM

COMPANY Fleming & Woodman

CONTRACTOR Brack Drlg.


Wildcat

330 Ft. from N. Line

Ft. from S. Line

330 Ft. from E. Line

Ft. from W. Line

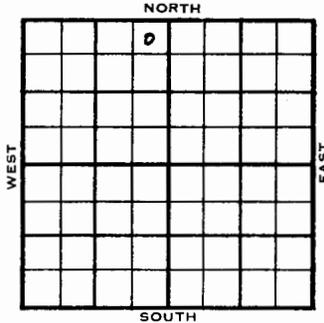

NE NEW

Sun, Sunray & Shell - DHM

1954	ELEVATION 2045'	REPORT
------	-----------------	--------

12/1 M I R

12/15 Spud 11-30-54  
 D & A  
 TD 3650'  
 Anhy 1160'  
 8-5/8" @ 1171'  
 Heeb 3284' Tor. 3302' Lans 3334'  
 DST 3351'-3413' opn 1 hr, rec 250' gas  
 50' so & gcm 120' Muddy gassy s.w.  
 240' s.w. 990#  
 DST 3568'-93' opn 1 hr, rec 15' Mud  
 1# hvy blk. oil O# Arb. 3601'  
 DST 3604'-18' opn 1 hr, rec 260' s.w.  
 500#  
 TD 3650'  
 D & A

ABANDONED

DX 78-1

Rush

KANSAS

Section 27 Township 16 Range 17 W.

Well No. # 1 Holzmeister

Company Fleming & Woodman

