

County **Rush** State **Kansas**
 Sec. **1** (Blk. Twp.) **16** (Sur. Rge.) **16W** Map No.

Operator Prime Drlg.

Well No. **1** Farm **Gateschalk**

Elev.	Location	NE NE NE
-------	----------	----------

0

FIRST REPORT

330 Ft. From **N** Line **NE**

350 Ft. From **E** Line Quarter

1st. Report APR 9 1952

Completion

Remarks Stanolind - PO

Prime - Contr.

Spudding DateDrlg. Data

Dr 1g.

County	Rush		State	Kansas
Sec.	1	(Blk. Twp.)	16	(Sur. Rge.) 18W Map No.

Operator Prime Drlg.

Well No. 1 Farm Gateschalk

Elev.	1910	Location	NE NE NE
-------	------	----------	----------

330 Ft. From N Line NE

330 Ft. From E Line Quarter

1st. Report

Completion APR 30 1952

Remarks

Prime D_rlg. - Contr.

Spudding Date 4-7-52

Drig. Data D & A TD 3505

8" @ 1070 Lans. 3211 B KC 3436

Cong. 3462 Arb. 3492 TD 3505

DST 3492-95 open 1 hr. Rec. 120' mud

60' salty water DST 3358-68 open 1 hr.

Rec. 30' mud DST 3368-81 open 1 hr.

Rec. 30' mud

D & A

J. G. McGEHEE

J. G. McGee, Jr.

Rush KANSAS

Sec. 1 Twp. 16 R. 18 W
Well No. #1 Gateschalk Farm

Prime Drlg.

Company

Prime

Contractor

330 Ft. from N. Line


Ft. from S. Line

330 Ft. from E. Line

Ft. from W. Line

NE NE NE

Stanolind - FO

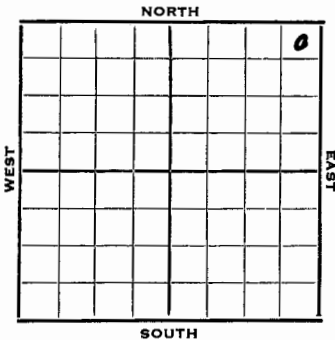


KANSAS

Section 1 Township 16 Range 18W

Well No. #1 Gateschalk

Company Prime Drlg.

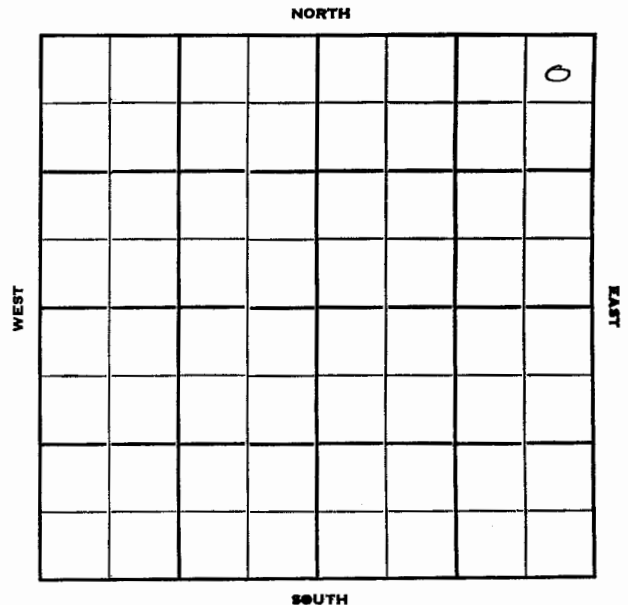

1952 Elev. 1910' REPORT

4/9 Drilling
4/23 8" @ 1070' Lans. 3211'
DST 3358-68, 1 hr, 30' M 140#
DST 3368-81, 1 hr, 30' M 35#
B KC 3436' Cong. 3462' Arb. 3492'
DST 3492-95, 1 hr, 120' M, 60' salty
water. 1070# TD 3505'
Running electric log.
Spud 4-7-52
4/30 D & A TD 3505' 8" @ 1070
Lans. 3211' B KC 3436' Cong. 3462'
Arb. 3492' TD 3505'
DST 3492-95 open 1 hr. rec 120' mud
60' salty water.
DST 3358-68 open 1 hr. rec 30' mud
DST 3368-81 open 1 hr. rec 30' mud.
D & A

ABANDONED