

Rush

Map No. 74 Sec. 2 Twp. 16 R. 18WWell No. 1 E. HerrmanLuther Mackall et al. Company**FIRST REPORT**

Contractor


C E L S E N E

Ft. from N. Line

660 Ft. from S. Line330 Ft. from E. Line

Ft. from W. Line

SECTION PLAT

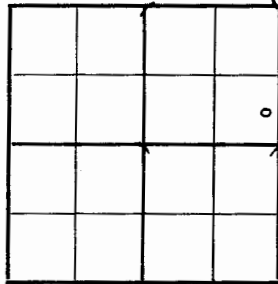

WILDCAT

Location

Rig up

Drilling and Remarks:

Surface Hole

RECORD

Cased in, ft.

Sand

Gas

Oil

Total Depth

PRODUCTION

1st 24 hrs. Nat.

1st 24 hrs. after shot

Gas Cu. Ft.

Dry Hole

Abandoned

Date

FEB 18 1942 19 S. J. LEWIS Scout

Rush

MANGAS

Map No. 74 Sec. 2 Twp. 16 R. 18WWell No. 1 E. HerrmanLuther Mackall et al. Company**ABANDONED**

Contractor


C E L S E N E

Ft. from N. Line

660 Ft. from S. Line330 Ft. from E. Line

Ft. from W. Line

SECTION PLAT

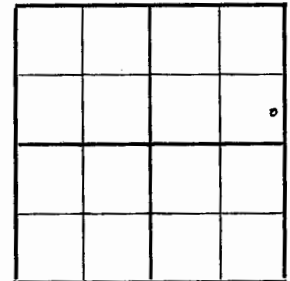

WILDCAT

Location

Rig up

Drilling and Remarks:

Line 3265Qty 35213552XFW

RECORD

Cased in, ft.

Sand

Gas

Oil

Total Depth 3576

PRODUCTION

1st 24 hrs. Nat.

1st 24 hrs. after shot

Gas Cu. Ft.

Dry Hole

Abandoned

Date


MAR 25 1942 19 S. J. LEWIS Scout

KANSAS

Rush

Sec 2 Twp. 16 R. 18-WWell No. #1 E. Herrman FarmLuther Mackall et al Company
(Wildcat) Ft. from N. Line660 Ft. from S. Line330 Ft. from E. Line Ft. from W. Line

Elev. 1979

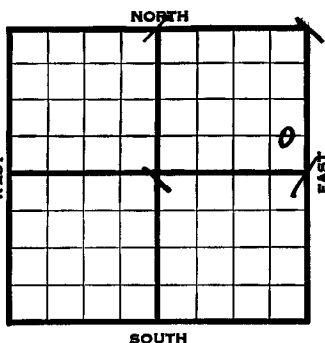

REPORT

1942
2/18 Surface hole.
2/26 10" - 94' 900' run pipe.
3/5 8" - 1149' Anhy 1135' WOC.
3/12 Drlg. 2415'
3/19 Lans. 3265' Cong. 3521'
SSO 3552-56' T.D. Run 5".

~~EXC~~

3/25 Lans. 3265'
Cong. 3521'
5" - 3552'
T.D. 3576'
H.F.W.

ABANDONED

KANSAS

Rush

FORM 51 5M 1-42 PETROL

Section 2 Township 16 Range 18-WWell No. 1 E. HerrmanCompany Luther Mackall et al