

SIDE ONE

AFFIDAVIT OF COMPLETION FORM

State Geological Survey
WICHITA, BRANCH (REV) ACO-1

This form shall be filed in duplicate with the Kansas Corporation Commission, 200 Colorado Derby Building, Wichita, Kansas 67202, within ten days after the completion of the well, regardless of how the well was completed.

Attach separate letter of request if the information is to be held confidential. If confidential, only file one copy. Information on side one will be of public record and side two will then be held confidential.

Circle one: Oil, Gas, Dry, SWD, OWWO, Injection. Type and complete ALL sections. Applications must be filed for dual completion, commingling, SWD and injection.

Attach wireline logs (i.e. electrical log, sonic log, gamma ray neutron log, etc.). KCC # (316) 263-3238. (Rules 82-2-105 & 82-2-125)

OPERATOR ENERGY THREE, INC.API NO. 15-165-20,985ADDRESS P. O. Box 1505COUNTY RUSHGREAT BEND, KANSAS 67530

FIELD _____

**CONTACT PERSON R. D. STANDLEE

PROD. FORMATION _____

PHONE AC 316 - 792 - 5968LEASE BIEKER

PURCHASER _____

WELL NO. 1

ADDRESS _____

WELL LOCATION NW SE NWDRILLING BIG THREE DRILLING, INC.990 Ft. from SOUTH Line and

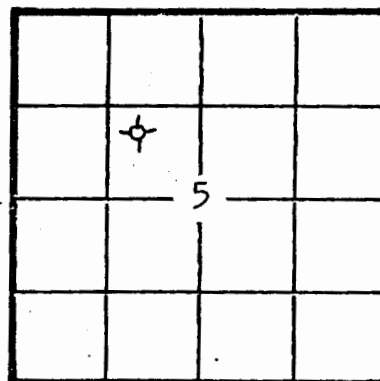
CONTRACTOR

990 Ft. from EAST Line ofADDRESS P. O. Box 52the NW/4 SEC. 5 TWP. 16S RGE. 18WGORHAM, KANSAS 67640

WELL FLAT

PLUGGING SUN OILWELL CEMENTING

CONTRACTOR

ADDRESS GREAT BEND, KANSASKCC _____
KGS _____
(Office Use)TOTAL DEPTH 3660 PBD _____SPUD DATE 3-31-82 DATE COMPLETED 4-8-82ELEV: GR 2010 DF _____ KB 2015DRILLED WITH (CABLE) (ROTARY) (AIR) TOOLSAmount of surface pipe set and cemented 1191' DV Tool Used? NO

AFFIDAVIT

STATE OF KANSAS, COUNTY OF RUSH SS, I, _____R. D. STANDLEE OF LAWFUL AGE, BEING FIRST DULY SWORN UPON HIS OATH,DEPOSES THAT HE IS EXECUTIVE VICE-PRES. (XXX) (OF) ENERGY THREE, INC.OPERATOR OF THE BIEKER LEASE, AND IS DULY AUTHORIZED TO MAKETHIS AFFIDAVIT FOR AND ON THE BEHALF OF SAID OPERATOR, THAT WELL NO. 1 ONSAID LEASE WAS COMPLETED AS OF THE 8TH DAY OF APRIL, 19 82, AND THAT

ALL INFORMATION FURNISHED HEREIN WITH RESPECT TO SAID WELL IS TRUE AND CORRECT.

STATE RECEIVED
CORPORATION COMMISSION

#1 Bieker

R1

5-16-18w

ald

SIDE TWO

WELL LOG

Show all important zones of porosity and contents thereof; cored intervals, and all drill-stem tests, including depth interval tested, cushion used, time tool open, flowing and shut-in pressures, and recoveries.

SHOW GEOLOGICAL MARKERS, LOGS RUN, OR OTHER DESCRIPTIVE INFORMATION.

FORMATION DESCRIPTION, CONTENTS, ETC.	TOP	BOTTOM	NAME	DEPTH
TOP SOIL - SAND	-0-	445	GREAT GUNS RAN OPEN HOLE LOG FROM 3660' TO -0- 4-7-82..	
SAND & SHALE	445	1182		
ANHYDRITE	1182	1192		
SAND, SHALE, LIME	1192	1875		
SHALE	1875	2335		
SHALE & LIME	2335	3660	ELEC. LOG TOPS:	
		RTD		
			HEEBNER	3266
			TORONTO	3287
			LANS.-KC	3312
			BASE OF KC	3530
			ARBUCKLE	3637
State Geological Survey WICHITA, BRANCH				
DRY HOLE				

Report of all strings set — surface, intermediate, production, etc. CASING RECORD (New) or (Used)

Purpose of string	Size hole drilled	Size casing set (in O.D.)	Weight lbs/ft.	Setting depth	Type cement	Sacks	Type and percent additives
SURFACE	12 1/4	8 5/8	23 #	1191'	60/40 Poz COMMON	200 200	3 % GEL, 3% CC 3 % GEL, 2% CC

LINER RECORD

PERFORATION RECORD

Top, ft.	Bottom, ft.	Sacks cement	Shots per ft.	Size & type	Depth interval
TUBING RECORD					
Setting depth	Pecker set at				

STATE RECEIVED