

Rush

KANSAS

Sec. 5 Twp. 16 R. 18 W

Well No. #1 Herklotz ^{LEIKER} Farm

Company Veeder Supply

Contractor Veeder Supply

Wildcat


330 Ft. from N. Line

Ft. from S. Line

330 Ft. from E. Line

Ft. from W. Line

NE NE SW

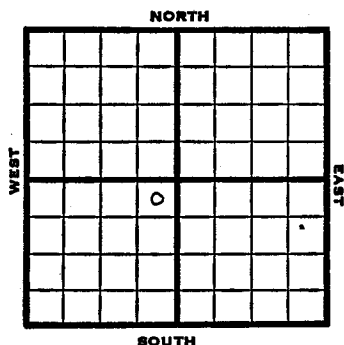

KANSAS


Rush

Section 5 Township 16 Range 18W

Well No. #1 Herklotz ^{LEIKER}

Company Veeder Supply

NORTH

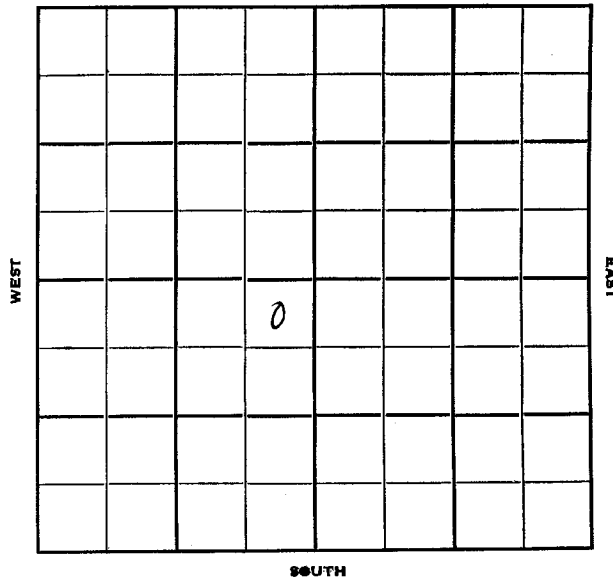

SOUTH

1951 Elev. 2027' REPORT

5/29 Spudding 5-27-51
Drlg. 1035'

6/13 Spud 5-27-51 D & A TD 3670'
Anhy 1202' Heeb 3274' Lans 2325'
DST 3332-60 open 1 hr. rec 155' water
DST 3500-26 open 1 hr. rec 30' OCM
Arb. 3616' ReArb. 3600'
DST 3616-20 open 1½ hr. rec 90' oil
& water 50% oil TD 3670'
D & A

ABANDONED