

KANSAS ✓

Sec. 5 Twp. 16 R. 18W

Well No. #1 Herklotz Farm

Lindas Oil Company

Lindas - Contr. Contractor
Wildcat


330' Ft. from N. Line

_____ Ft. from S. Line

_____ Ft. from E. Line

330' Ft. from W. Line

NW NW SW

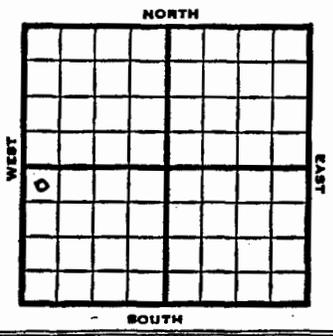

1952	Elev. 2026'	REPORT
5/21	Spud 5-14-52 8" @922 Drlg. 2333	
5/28	Heeb. 3282 Tor. 3295 Base Oread 3309 Lans. 3318 DST 3325-36, 1 hr. 5' m O# DST 3345-52, 1 hr. 32' w & m 1250# DST 3495-3506, 1 hr. 7' w & m Arb. 3613 DST 3602-14, 1 1/2 hrs. 185' O&GCM 720#	
6/11	TD 3614' 5" @ 3613 CO 3614 1/2 BOPH DD 3618' TD 2 1/2 BOPH 250 A 3 1/2 BOPH P/36 BO plus 3 1/2 BWPD	
6/18	NR	
6/25	10 BO & 10 BWPD	
7/2	PB 3613 1/3610-12 500 A S/1 1/2 boph 8/3610-12 S2 1/2 BOPH 1000 A S/2-3/4 BOPH PB 3608 20/3601-05 S/3 1/2 Bfph 50% wtr DP 3613 tub & rods	
7/9	P/23 BO & 26 BWPD	
7/17	P/19 BO & 58 BW 19 hrs.	
7/23	P/ b Bo & 21 Bwpd	
7/30	NR	
8/6	"	
8/13	CO 3617 1/2	OVER

1952
8/20 NR
8/27 PB 3614 1/2
9/3 PB 3612 1/2 S/ 1/2 Bo & 1 Bwph PB 3612
S/ 3/4 galo & 3 Bwph 16/3601-05
set plug 3606 S/ 4/0 galo & 7/4 galwph

9/10 Spud 5-14-52 D&A TD 3618
8" @ 922 Heeb. 3282 Tor. 3295
B. Oread 3309 Lans. 3318
DST 3325-36 opn 1 hr. Rec. 5' mud
O# DST 3345-52 opn 1 hr. Rec. 32'
wtr & mud 1250#
DST 3495-3506 opn 1 hr. Rec. 7' wtr.
& mud O# Gorham sd 3601
Arb 3613
DST 3602-14 opn 1 1/2 hr. Rec. 185' o
& GCM 720# TD 3614 5" @ 3631
CO to 3614 B/ 1/2 BOPH DD 3618
S/2 1/2 boph 250A S/3 1/2 boph
P/36 bo 3 1/2 bwpd 12 bo 6 bwpd
10 bo 10 bwpd PB 3613
1/3610-12 500 A S/1 1/2 boph
8/3610-12 S/2 1/2 boph 1000 A
S/2-3/4 boph PB 3608
20/3601-05 S/3 1/2 bfph 50% wtr
DP 3613 P/23 bo 26 bwpd
P/19 bo 58 bw 19 hr. P/5 bo 21 bw
Co to 3617 PB 3614 PB 3612 1/2
S/ 1/2 bo 1 bwph PB 3612 S/3/4 go
3 bwph 16/3601-05 SP 3606
S/40 go 7/4 bwph D&A

ABANDONE!