

Map No. 74 Sec. 7 Twp. 16 R. 18W
 Well No. 1- Werth
National Ref Company
 Contractor

FIRST REPORTS

SECTION PLAT

330 Ft. from N. Line
 _____ Ft. from S. Line
990 Ft. from E. Line
 _____ Ft. from W. Line

			0

Location _____
 Rig up _____
 Drilling and Remarks:

Cable Rig

RECORD
 Cased _____ in., _____ ft.
 Sand _____
 Gas _____
 Oil _____
 Total Depth _____

PRODUCTION
 1st 24 hrs. Nat. _____
 1st 24 hrs. after shot _____
 Gas _____ Cu. Ft.
 Dry Hole _____
 Abandoned _____

Date

3-11-36

192

ORVAL MANNSCHRECK

Scout

Map No. 74 Sec. 7 Twp. 16 R. 18W
 Well No. 1 Werth
National Ref Company
 Contractor

SECTION PLAT

330 Ft. from N. Line
 _____ Ft. from S. Line
990 Ft. from E. Line
 _____ Ft. from W. Line

			0

ABANDONED

Location _____
 Rig up _____
 Drilling and Remarks:

Regan Sand 3624
HPW

JYA

RECORD
 Cased _____ in., _____ ft.
 Sand _____
 Gas _____
 Oil _____
 Total Depth 3625

PRODUCTION
 1st 24 hrs. Nat. _____
 1st 24 hrs. after shot _____
 Gas _____ Cu. Ft.
 Dry Hole _____
 Abandoned _____

Date

JUN 24 1936

19

S. J. LEWIS

Scout

Map No. 7 Sec. 16 Twp. 18 R. 18

Well No. 1-Werth Farm

National Ref. Company


330 Ft. from N. Line

Ft. from S. Line

990 Ft. from E. Line

Ft. from W. Line

Elev. 2029

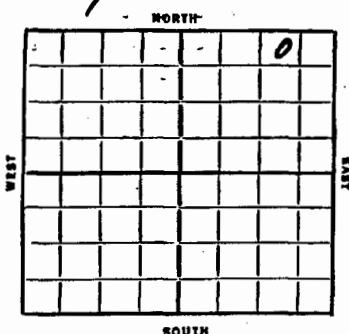

6/24/36-Reagan Sand 3624'.

H.F.W.

T.D. 3625'.

D&A.

ABANDONED

REPORT

3/11 Cable Rig

3/13 --

3/20 --

3/27 20"-20' Drlg. 350'

4/2 15"-493' Drlg. 565'

4/10 Drlg. 1165'

4/16 Drlg. 1975'

4/23 Drlg. 2560'

4/30 --

5/8 Drlg. 3100'.

5/14 S.G. 3015'-25'. 1 BW 3050'-60'.
8" @ 3265'. S.O. 3335'. S.O. 3346-
48'. 1/2 BW 3355'. Drlg. 3408'.

5/21 8" @ 3400'. S.O. 3511-16'. S.O.
3552-58'. T.D. 3572'. Swabb 50 bbls
per day.


5/28 --6/4--

6/10 Total Depth 3572 in Lansing
No top determined yet
800 feet oil in 24 hrs. Acidized with
5000 gallons acid 424 bbls. in 24 hrs.
2% water (Tel)

RUSH

Form 51-5M-3-85-Mid-West

 Well No. **1-Worth** Farm _____
National Ref. Company _____

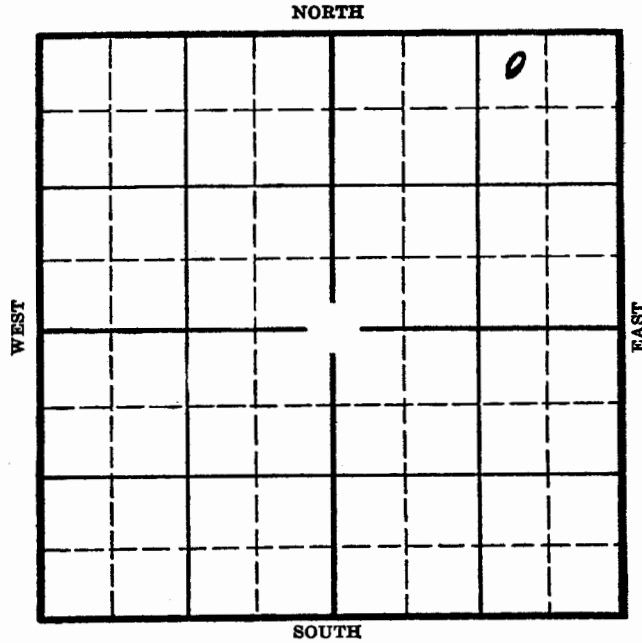

Location _____

Drilling Remarks _____

Rig Up _____

Drilling Remarks _____

RECORD

Cased _____ in. _____ ft.
 Sand _____
 Gas _____
 Oil _____
 Total Depth _____

PRODUCTION

1st 24 hrs. Nat. _____
 1st 24 hrs. after shot _____
 Gas _____ cu. ft.
 Dry Hole _____
 Abandoned _____