

Pool Name Wildcat
 Kansas
 Map No. 74 Sec. 9 Twp. 16 R. 18W
 Well No. 1 Schneider

Pool Name Wildcat
 Kansas
 Map No. 74 Sec. 9 Twp. 16 R. 18W
 Well No. 1 Schneider

Sohio etal.

Company


FIRST REPORT

Contractor

SW NW

SECTION PLAT

Ft. from N. Line
 330 Ft. from S. Line
 Ft. from E. Line
 330 Ft. from W. Line

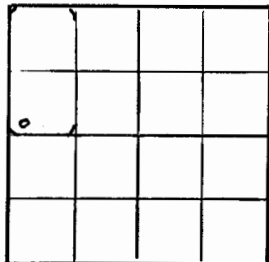

Rush County

Location

Rig up

Drilling and Remarks:

Anhy 1165

10" @ 1169

WOC

RECORD

Cased _____ in. _____ ft.

Sand _____

Gas _____

Oil _____

Total Depth _____

PRODUCTION

1st 24 hrs. Nat. _____

1st 24 hrs. after shot _____

Gas _____ Cu. Ft.

Dry Hole _____

Abandoned _____

Date

AUG 21 1946

19

S. J. LEWIS

Scout

Sohio etal.

Company


ABANDONED

Contractor

SW NW

SECTION PLAT

Ft. from N. Line
 330 Ft. from S. Line
 Ft. from E. Line
 330 Ft. from W. Line

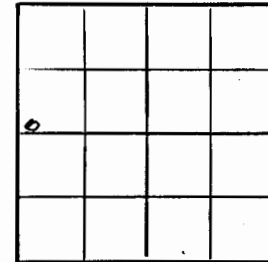

Rush County

Location

Rig up

Drilling and Remarks:

Reagan 8608
W.F.W.

RECORD

Cased _____ in. _____ ft.

Sand _____

Gas _____

Oil _____

Total Depth 9628

PRODUCTION

1st 24 hrs. Nat. _____

1st 24 hrs. after shot _____

Gas _____ Cu. Ft.

Dry Hole _____

Abandoned _____

Date

SEP 18 1946

19

S. J. LEWIS

Scout

KANSAS

Rush County

Sec. 9 Twp. 16 R. 18W

Well No. #1 Schneider Farm

Sohio et al Company

Wildcat


 Ft. from N. Line

330 Ft. from S. Line

 Ft. from E. Line

330 Ft. from W. Line

SW NW

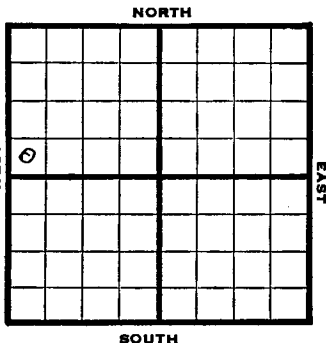

1946 Elev. 1996' REPORT

8/21 Anhy. 1165
10" @ 1169
WOC
8/27 Drlg 2480'
9/5 Lans 3265
Reggan 3565
TD 3572'
SO run csg.
9/10 5" @ 3599 RUST
9/18 Reagan 3609'
HFW
TD 3628'

ABANDONED

KANSAS

Rush

Section 9 Township 16 Range 18-W

Well No. #1 Schneider

Company Sohio et al

