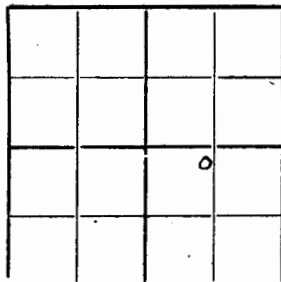


MAP NO. 74 KANSAS SEC. 10 TWP. 16 R. 18WWELL NO. 1 LegleiterPhillips Pet. COMPANY

CONTRACTOR

SECTION PLAT

330 FT. FROM N. LINE

_____ FT. FROM S. LINE

_____ FT. FROM E. LINE

990 FT. FROM W. LINE

FIRST REPORTS

LOCATION ✓

RIG UP _____

DRILLING AND REMARKS:

RECORD

CASED _____ IN. _____ FT.

SAND _____

GAS _____

OIL _____

TOTAL DEPTH _____

PRODUCTION

1ST 24 HRS. NAT. _____

1ST 24 HRS. AFTER SHOT _____

GAS _____ CU. FT.

DRY HOLE _____

ABANDONED _____

DATE

OCT 31 1928

192


S. J. LEWIS

SCOUT

Map No. 74 KANSAS Sec. 10 Twp. 16 R. 18WWell No. 1 LegleiterPhillips Pet. Company

Contractor

SECTION PLAT

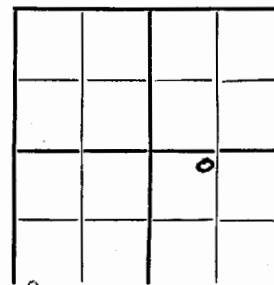330 Ft. from N. Line

_____ Ft. from S. Line

_____ Ft. from E. Line

990 Ft. from W. Line

Location _____

Rig up _____

Drilling and Remarks:

XFW 3620-3743JFH

RECORD

Cased _____ in., _____ ft.

Sand _____

Gas _____

Oil _____

Total Depth 3260

PRODUCTION

1st 24 hrs. Nat. _____

1st 24 hrs. after shot _____

Gas _____ Cu. Ft.

Dry Hole _____

Abandoned _____

Date


_____ 192

S. J. LEWIS

Scout

Rush
Map No. KANSAS Sec. 10 Twp. 16 R. 18^W
Well No. 1- Legleiter Farm
Phillips Pet Company

330 Ft. from N. Line
_____ Ft. from S. Line
_____ Ft. from E. Line
990 Ft. from W. Line

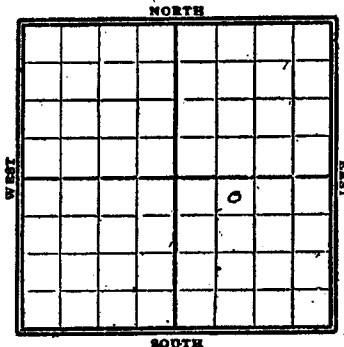


1928

Date	REPORT
10/31	Location
11/7	
11/14	
11/21	Roll
11/28	Rigging up
12/5	
12/12	
12/19	
12/26	
1929	
1/2	Spud 150'
1/9	" 250'
1/16	" 350'
1/23	drly 440'
1/30	log tools 440'-T.D.
2/6	drly 975'
2/13	" 1070' - HFW
2/20	" 1150'
2/27	" 1345'
3/6	" 1945'
3/13	" 2430'
3/20	" 2700'

3/27- Drly 2970'
4/3- " 3240'
4/9 Top sand 3570'
Est 34 gas
Lost tools & fsg.
4/10 _____
4/13 Top Oswald 3297
Top Sorham 3570'
T.D. 3573
1500' oil & water
hole casing
4/17 T.D. 3573- fsg tools
4/24- Drly 3576'
5/1 " 3620' 4"-3614'
5/8 H.F.W. 3620-Drly 3743
5/14 Drly 3757'
5/22 HFW- 3620-3743
T.D. 3760'
Dry & Abandoned

Map No. KANSAS Sec. 10 Twp. 16 R. 18^w
 Well No. 1- Legleiter Farm
Philips Company

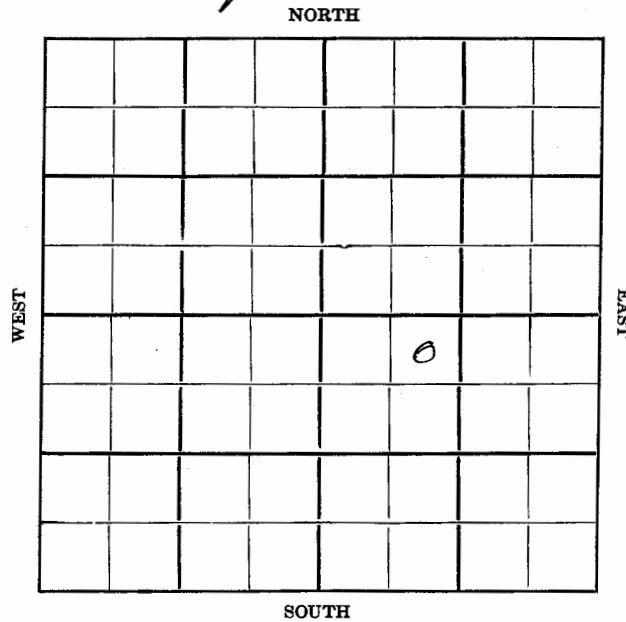

Location.....
 Drilling Remarks

Rig Up.....
 Drilling Remarks

RECORD

Cased.....in.....ft.
 Sand.....
 Gas.....
 Oil.....
 Total Depth.....

PRODUCTION

1st 24 hrs. Nat.....
 1st 24 hrs. after shot.....
 Gas.....cu. ft.....
 Dry Hole.....
 Abandoned.....