

Kansas Pool Name AlbertMap No. 74 Sec. 20 Twp. 16 R. 18WWell No. 1 SuhckmanVickers & B & R Company

FIRST REPORT

Contractor

NW/c

SECTION PLAT

330 Ft. from N. Line Ft. from S. Line Ft. from E. Line330 Ft. from W. Line

0			

Rush County

Location X

Rig up

Drilling and Remarks:

RECORD

Cased in., ft.Sand Gas Oil Total Depth

PRODUCTION

1st 24 hrs. Nat. 1st 24 hrs. after shot Gas Cu. Ft.Dry Hole Abandoned

Date

MAY 2 1945 19 S. J. LEWIS ScoutKansas Pool Name WildcatMap No. 74 Sec. 20 Twp. 16 R. 18WWell No. 1 SuhckmanVickers and B & R Company

ABANDONED

Contractor

NW/c

E/2018
SECTION PLAT330 Ft. from N. Line Ft. from S. Line Ft. from E. Line330 Ft. from W. Line

0			

Rush County

Location

Rig up

Drilling and Remarks:

Line 3307
Comp 3582
Barrel 3596
Quartzite 364

RECORD

Cased in., ft.Sand Gas Oil Total Depth 3619

PRODUCTION

1st 24 hrs. Nat. 1st 24 hrs. after shot Gas Cu. Ft.Dry Hole Abandoned

Date

MAY 2 3 1945 19 S. J. LEWIS Scout

KANSAS

Rush County

Sec. 20 Twp. 16 R. 18W

Well No. 1 Suhckman Farm

Vickers & B & R Company

Albert


330 Ft. from N. Line

Ft. from S. Line

Ft. from E. Line

330 Ft. from W. Line

NW/c

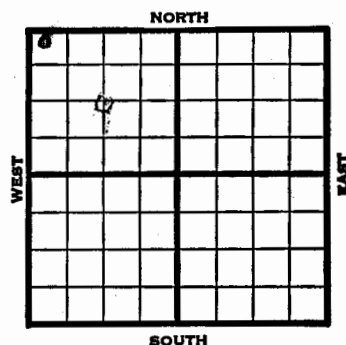

1945 Elev. 2019 REPORT

5/2 Location

5/10 " "
5/17 Drlg. 2545
5/23 Lans 3307
Cong 3582
Basal Sd. 3596
Quartzite 3614
TD 3619'

ABANDONED

KANSAS

Rush

FORM 51 5M PETROL

Section 20 Township 16 Range 18W

Well No. 1 Suhckman

Company Vickers & B & R

