


County Rush State Kansas
 Sec. 20 (Blk. Twp.) 16 (Sur. Rge.) 18W Map No.
 Operator Bay Pet., Strain Drlg. & Buffalo Oil
 Well No. 1 Farm Dechant
 Elev. Location SE SE SE

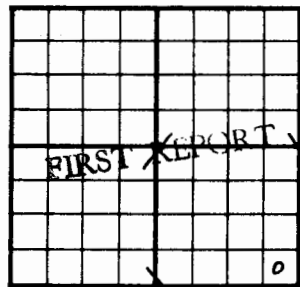


330 Ft. From S Line SE
330 Ft. From E Line Quarter
 Ist. Report FEB 3 1954
 Completion
 Remarks
Strain Drlg. - Contr.
 Spudding Date 1-29-54

Drlg. Data Wildcat

10" @ 123 drlg. 2060

J. G. McGEHEE

County Rush State Kansas
 Sec. 20 (Blk. Twp.) 16 (Sur. Rge.) 18W Map No.
 Operator Bay Pet., Strain Drlg. & Buffalo Oil
 Well No. 1 Farm Dechant
 Elev. 1997 Location SE SE SE

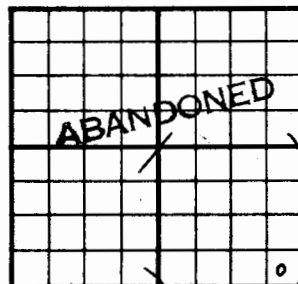

330 Ft. From S Line SE
330 Ft. From E Line Quarter
 Ist. Report
 Completion FEB 17 1954
 Remarks Wildcat
Strain Drlg. - Contr.
 Spudding Date 1-29-54

Drlg. Data D & A TD 3581

10" @ 123 Top. 2938 DST 3132-62

open 1 hr. Rec. 10' mud 960#

Heeb. 3229 Tor. 3242 Lens. 3274

DST 3275-98 open 1 hr. Rec. 90' wtr.

1075# DST 3306-30 open 1 hr. Rec.

5' mud 0# DST 3329-77 open 1 hr.

Rec. 350' sw 1115# DST 3432-50

open 1 hr. Rec. 144' sw 775#

B KC 3503 Cong. 3545 Regan 3568

DST 3568-74 open 1 hr. Rec. 30' mud

1100# Gr. 3573 TD 3581

D & A

J. G. McGEHEE

Rush KANSAS
 SEC. 20 TWP. 16 R. 18 W ✓
 WELL NO.
 # 1 Dechant FARM
 COMPANY
 Bay Pet., Strain Drlg. & Buffalo Oil
 CONTRACTOR

Strain Drlg.

Wildcat


_____ Ft. from N. Line

330 _____ Ft. from S. Line

330 _____ Ft. from E. Line

_____ Ft. from W. Line

SE SE SE

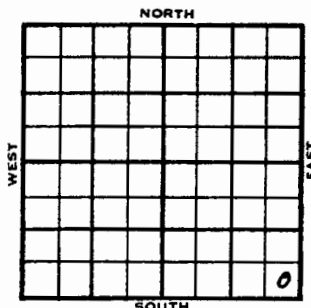

	ELEVATION	REPORT
1954	1997'	
2/3	Spud 1-29-54 10" @ 123 Drlg. 2060'	
2/10	Top 2938' DST 3132-62, 1 hr, 10' M 960# Heeb 3229' Tor 3242' Lans 3274 DST 3275-98, 1 hr, 90' wtr. 1075# DST 3306-30, 1 hr, 5' M 0# Drlg.	
2/17	Spud 1-29-54 D & A TD 3581' 10" @ 123' Top 2938', DST 3132'-62' opn 1 hr, rec 10' Mud 960# Heeb 3229', Tor 3242' Lans 3274' DST 3275'-98' opn 1 hr, rec 90' Wtr. 1075# DST 3306'-30' opn 1 hr, rec 5' Mud 0# DST 3329'-77' opn 1 hr, rec 350' SW 1115# DST 3432'-50' opn 1 hr, rec 144' SW 775# B KC 3503', Cong 3545', Regan 3568' DST 3568'-74' opn 1 hr, rec 30' Mud	

OX-78

1954

Information brought forward.

2/17

1100#

Gr. 3573'

TD 3581'

D & A

ABANDONED

FORM 51

Rush

KANSAS

Section 20 Township 16 Range 18 W

Well No. # 1 Dechant

Company Bay Pet., Strain Drlg. & Buffalo Oil

NORTH

							0

SOUTH

WEST

EAST
