

State Kansas County Ellsworth

Company Okmar Oil Co. Well No. 1

Farm Buehler


Survey _____

Block No. _____ Sec. 18 Twp. 16 S Range 10 W

Co-Ord. _____ Elev. _____

SW/4 SW/4 NE/4

Contr. - M-R

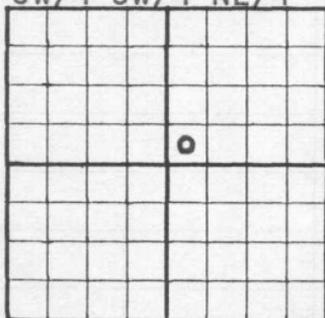

100% - Okmar Oil Co.

3500' Arb. test to be comm
by 11/3/64

NOTE: Show Sketch of Lease and Well Location in Above Space

Ft. from N. Line

Ft. from S. Line

Ft. from W. Line

Ft. from E. Line

Date	Depth	
11/2/64		M.I.R.T. - Spud - 8-5/8" @ 343' w/175 sx. cem., 2% gel., 2% c.c., P.D. @ 4:45 a.m. 11/3/64
11/4	900	Drlg.
11/5	1825	Drlg. (0° @ 1000') (1/4° @ 1590')
11/6	2425	Drlg.
11/7	2825	Drlg.
11/9	3125	Drlg. (1/4° @ 3075)

693472

Date	Depth	
DST #1	- 3060=75	- Rec. 30' mud w/oil spts.
DST #2	- 3178=91	- Rec. 65' mdy gsy oil & 780' gas
	3342	Arbuckle
11/10	3248	Drlg. Depth.
DST #3	- 3343-3352'	- Rec. 40' gsy oil 110' mdy oil, 150' gas
	3352	R.T.D.
		5 1/2" @ 3346' w/200 sx. cem., P.D. @ 6:45 p.m. 11/11/64