

State Kansas County Ellsworth

Company Messman-Rinehart Oil Co. Well No. 1

Farm Klema


Survey

Block No. Sec. 18 Twp. 16 S Range 10 W

Co-Ord. Elev. 1892' K/F
1890' D/F

SE/4 NE/4 SW/4

M-R Rig

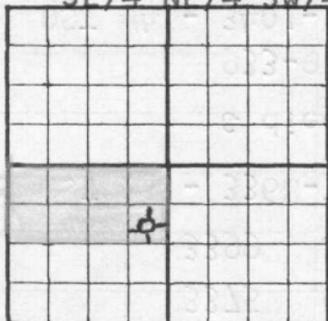

50% - A. A. Seeligson, Jr
21.429% - Chicago Group
(Anderson, Clements, Chadwell, McDermott, McNeill, Plym)
28.571% - M-R Oil Co.

3400' Arb. test to be comm. by 10/10/64

NOTE: Show Sketch of Lease and Well Location in Above Space

990

Ft. from N. Line

Ft. from S. Line

Ft. from W. Line

330

Ft. from E. Line

Date	Depth	
11/12/64		M.I.R.T. - Spud - 8-5/8" @ 347' w/175 sx. cem., 4 gel., 4 c.c., P.D. @ 12:30 a.m.
		11/13/64
11/14	1075	Drlg.
	720	Anhydrite (+1172)
11/15	1875	Drlg.
11/16	2480	Drlg.
11/17	2810	Drlg.

Date	Depth	693484
11/18	3045	Drlg.
	2933	Heebner (-1041)
	3032	Brown Lime (-1140)
	3050	Lansing (-1158)
DST #1 - 3076=89' - Op 1 hr. good bl., Rec. 180' gas & 59' gsy mud w/spks. fr oil in tool, BHP 183-92#, FP18-27#		
11/19	3165	Drlg. (no drlg. brk. no lower zone in Ls.)
11/20	3310	Drlg. (3354-68 staping) in bottom 5'
DST #2 - 3355-67' - Op 1 hr., Rec. 20' oil specked mud, BHP 1025-967#, FP 18-18#		
	3375	Drlg.
	3399	Arbuckle (-1507)
DST #3 - 3368-79' - Op 30", wk. bl. for 3' & died, Rec. 10' mud, BHP (45") 933-915#, FP18-18#		
DST #4 - 3401-15' - Op 1½ hrs., good bl TO Rec. 2427' sulphur wtr., BHP (30") 988-988#, FP 55-988#		
	3415	R.T.D.
D & A 11/23/64		