


Rush County Kansas State
 Map No. Sec. 1 Twp. 16 R. 20W
 Well No. 1 Weitzell
 Heathman & Honaker Company
FIRST REPORT
 Contractor
 NE SW NW

SECTION PLAT

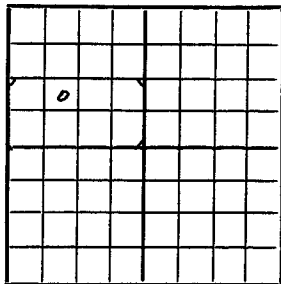


Ft. from N. Line
 990 Ft. from S. Line
 Ft. from E. Line
 990 Ft. from W. Line

Weitzell Pool
 Remarks:

8" @ 142 drlg. 3392

Date AUG 25 1948 Scout S. J. LEWIS

Rush County Kansas State
 Map No. 75 Sec. 1 Twp. 16 R. 20W
 Well No. 1 Weitzel
 Heathman & Honaker Company
ABANDONED
 Contractor
 NE SW NW
E1.2107
SECTION PLAT

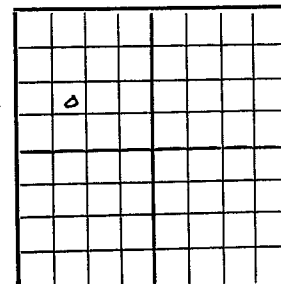

Ft. from N. Line
 990 Ft. from S. Line
 Ft. from E. Line
 990 Ft. from W. Line

Weitzel Pool
 Remarks:

Coing 3256
 J. D. 3742

Date SEP 8 1948 Scout S. J. LEWIS

KANSAS Rush



Sec. 1 Twp. 16 R. 20W

Well No. 1 Weitzell Farm

Heathman & Honaker Company

Weitzell Pool


 Ft. from N. Line

990 Ft. from S. Line

 Ft. from E. Line

990 Ft. from W. Line

NE SW NW

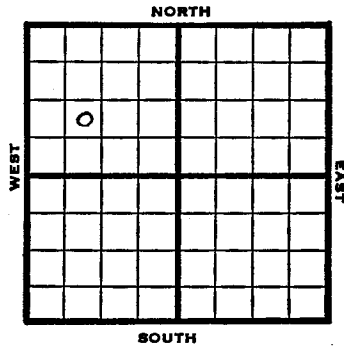

1948 Elev. 2107' REPORT

8/25 8" @ 142
Drlg 3392'
9/1 Lansing 3395'
TD 3742'
9/8 Cong. 3736'
TD 3742'

ABANDONED

KANSAS Rush

Section 1 Township 16 Range 20W

Well No. 1 Weitzell

Company Heathman & Honaker

Weitzell Pool

