

Map No. \_\_\_\_\_ Sec. 1 Twp. 16 R. 20W

Well No. 1 Weitzel

Darby & Bothwell Company

FIRST REPORT Contractor

SW NW

SECTION PLAT

0			

\_\_\_\_\_ Ft. from N. Line

330 Ft. from S. Line

\_\_\_\_\_ Ft. from E. Line

330 Ft. from W. Line

Rush County

Location X

RECORD

Cased \_\_\_\_\_ in., \_\_\_\_\_ ft.

Sand \_\_\_\_\_

Gas \_\_\_\_\_

Oil \_\_\_\_\_

Total Depth \_\_\_\_\_

PRODUCTION

1st 24 hrs. Nat. \_\_\_\_\_

1st 24 hrs. after shot \_\_\_\_\_

Gas \_\_\_\_\_ Cu. Ft.

Dry Hole \_\_\_\_\_

Abandoned \_\_\_\_\_

Date

MAR 12 1947 19

S. J. LEWIS Scout

Map No. K75 Sec. 1 Twp. 16 R. 20W

Well No. 1 Weitzel

Darby & Bothwell Company

COMPLETE Contractor

SW NW

SECTION PLAT

0			

\_\_\_\_\_ Ft. from N. Line

330 Ft. from S. Line

\_\_\_\_\_ Ft. from E. Line

330 Ft. from W. Line

Rush County

Location \_\_\_\_\_

RECORD

Cased \_\_\_\_\_ in., \_\_\_\_\_ ft.

Sand \_\_\_\_\_

Gas \_\_\_\_\_

Oil \_\_\_\_\_

Total Depth 8690

PRODUCTION

1st 24 hrs. Nat. \_\_\_\_\_

1st 24 hrs. after shot \_\_\_\_\_

Gas \_\_\_\_\_ Cu. Ft.

Dry Hole \_\_\_\_\_

Abandoned \_\_\_\_\_

Date

APR 23 1947 19

S. J. LEWIS Scout

*Comp. Cost \$ 675.*

*S. J. Lewis*

*Pump 1940*

*855*

KANSAS

Rush

Sec. 1 Twp. 16 R. 20-W

Well No. #1 Weitzel Farm

Darby & Bothwell Company


Wildcat

Ft. from N. Line

330 Ft. from S. Line

Ft. from E. Line

330 Ft. from W. Line

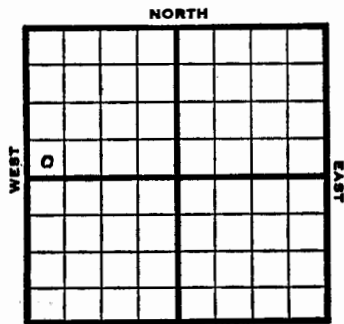

SW NW Elev. 2114'

REPORT

1947

3/12 Location

3/18 RUR

3/25 13" @ 160'  
Anhy 1320'  
Drlg 2120'

4/2 Topeka 3105'  
Lansing 3384'  
Drlg. 3413'.

4/9 BKC 3609  
Cong sand 3678  
TD 3690'  
DST 3678-90 open 1/2 hr rec 510'  
muddy oil  
5" @ 3678'  
RUST

4/15 TD 3680'  
Swb. 8 bbls. oil ph. 2 hrs.

4/23 Cong sd 3678  
5" @ 3678'  
Pump 194 Pot  
Grav. 35.5  
TD 3690'

**COMPLETED**

KANSAS

Section 1 Township 16 Range 20-W

Well No. #1 Weitzel

Company Darby & Bothwell

