

Weitzel Pool

Map No. _____ Sec. 1 Twp. 16 R. 2 OW

Well No. 2 Weitzel "A"

Darby & Bothwell Company

FIRST REPORT Contractor

NE NW SW


SECTION PLAT

330 Ft. from N. Line

_____ Ft. from S. Line

_____ Ft. from E. Line

990 Ft. from W. Line

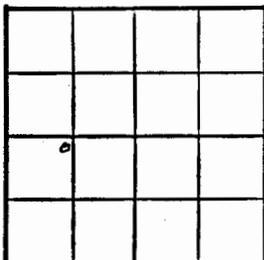

Rush County

Location X

Rig up _____

Drilling and Remarks:

RECORD

Cased _____ in., _____ ft.

Sand _____

Gas _____

Oil _____

Total Depth _____

PRODUCTION

1st 24 hrs. Nat. _____

1st 24 hrs. after shot _____

Gas _____ Cu. Ft.

Dry Hole _____

Abandoned _____

Date

DEC 3 1947 19 S. J. LEWIS Scout

Weitzel Pool

Map No. K-75 Sec. 1 Twp. 16 R. 2OW

Well No. 2 Weitzel "A"

Darby & Bothwell Company

ABANDONED Contractor

NE NW SW


SECTION PLAT

330 Ft. from N. Line

_____ Ft. from S. Line

_____ Ft. from E. Line

990 Ft. from W. Line

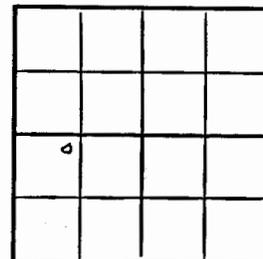

Rush County

Location _____

Rig up _____

Drilling and Remarks:

*None seen
Comp 0715*

RECORD

Cased _____ in., _____ ft.

Sand _____

Gas _____

Oil _____

Total Depth 0250

PRODUCTION

1st 24 hrs. Nat. _____

1st 24 hrs. after shot _____

Gas _____ Cu. Ft.

Dry Hole _____

Abandoned _____

Date

JAN 14 1948 19 S. J. LEWIS Scout

KANSAS Rush ✓

Sec. 1 Twp. 16 R. 20W

Well No. #2 Weitzel "A" Farm

Darby & Bothwell Company


Weitzel

330 Ft. from N. Line

_____ Ft. from S. Line

_____ Ft. from E. Line

990 Ft. from W. Line

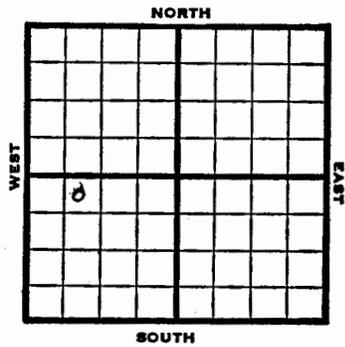

NE NW SW

Year	REPORT
1947	Elev. 2102'
12/3	Location
12/10	"
12/17	"
12/30	8" @ 1314' Drlg. 1665'
1948	
1/7	Drlg. 2835'
1/14	Lansing 3388' Cong. 3718' TD 3750' Abd.
ABANDONED	

KANSAS Rush

Section 1 Township 16 Range 20W

Well No. #2 Weitzel "A"

Company Darby & Bothwell

Weitzel

