

FORM 513 - SUNRAY

County Rush Elev. _____
Sec. 31 Twp. 16 Rge. 20W
Company Walch & Olsson
Farm Name North No. 1

TOPS	DEPTH	LOG	DATUM	Loc. in Sec. _____
Anb.				SE SE NE
Tr.				
H.				
Tr.				
Dg.				
Bl.				
L.				Geol. _____
K.C.				Sp. tools _____
B.K.C.				Pool <u>DAVENPORT</u>
Ce.				Wildcat
C.				
M.				
M.				
K.				
Nz.				
Ma.				
V.				
S.				
A				
R.				
PE.				
G.				
ED				

Geol. _____
Sp. tools _____
Pool DAVENPORT
Wildcat

FIRST REPORT

MAY 23 '56

Date Comm. Atl. FO Sunray MCPC - DIM
M I R

County Rush Elev. 2166
Sec. 31 Twp. 16 Rge. 20W
Company Weich & Olsson
Farm Name North No. 1

	DEPTH	LOG	DATUM	Loc in Sec.
				SE SE NE
	3536	3533		
	3556	3553		
Dg				
BL				
L.	3577	3571		
K.C.				Geol.
B.K.C.	3746	3845		Contr.
Ce.	3985	3980		Co. tools
C.	short 4016			Pool
M.				Wildcat
M.				
K.				
Mz.				
Mo.				
V.				
S.				
S.				
A	4078	4071		
R.				
PE				
G.				
TD	4110			ABANDONED

Date Comm. Atl. FO Sunray MOC - DEM
MIR MAY 29 '56 SPD 5-23-56 8 5/8
2211175 D 3220 JUN 6 '56
DST 4010-32 (60) cc 15' Mud
BHP 0
TD 4110 N.S. in Arb D & A
JUN 13 '56

SEC. **HOT FILE** Rush **KANSAS**

31 16 S 20 W

WELL NO.

1 North

FARM

COMPANY

Welch & Olsson Drlg. Co.

CONTRACTOR

Co tools

Wildcat

FT. FROM N. LINE

FT. FROM S. LINE

FT. FROM E. LINE

FT. FROM W. LINE

SE SE NE

SDX-DHC-\$3000.00

Atl. FO

1956

ELEVATION

2166 EL

REPORT

*Do Not advise
Contract Section
(WH6-DC23)*

5/31

Arbuckle Lime Test appx 4250'
To commence by June 1, 1956
To complete by July 1, 1956.
(See DHC Agreement)

5/23

MIR (FR Tkt)

5/31

Anhy 1427'
Drlg. 3475'

6/7

DST 4010-32, open 1 hr rec 15' mud.
O#. TD 4110' D & A

6/8

Holding for Log tops. (Ks. Sct. Ltr)

Comm. 5-22-56

Comp. 6-4-56

TD 4110'.

Plugged & Abandoned (See Comp. Letter
from Wichita District Office 6/8/56)

6-13

H. 3536', Tr. 3556', L. 3577',
B.K.C. 3846', Shale 3985', Chart 4016'
A. 4078'

Log: H 3533', Tr. 3553', L. 3571',
B.K.C. 3845', Shale 3980', A. 4071'

ABANDONED

Rush


KANSAS

SECTION 31 TOWNSHIP 16 RANGE 20W

WELL NO. #1 North

COMPANY Welch & Olsson

NORTH

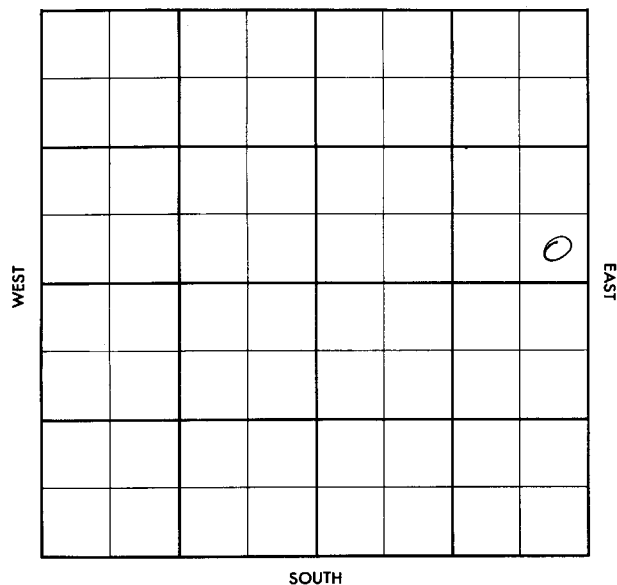

SOUTH