FORM 275 FOR SALE BY KANSAS BLUE PRINT CO.


County Ness State Kansas

Sec. 8 (Blk. Twp.) 16 (Sur. Rge.) 21W Map No.

Operator Ed Leben

Well No. 1 Farm Elmore

Elev. Location SW SW SW

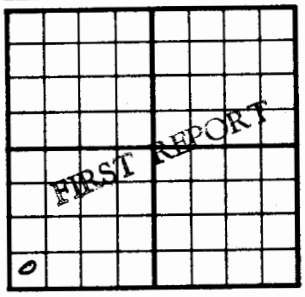

330 Ft. From S Line SW

330 Ft. From W Line Quarter

1st. Report SEP 26 1951

Completion

Remarks B & R Drlg. - Contr.

Spudding Date

Drlg. Data Wildcat

Location

J. E. TYRA

FORM 275 FOR SALE BY KANSAS BLUE PRINT CO.


County Ness State Kansas

Sec. 8 (Blk. Twp.) 16 (Sur. Rge.) 21W Map No.

Operator ~~Ed Leben~~ B + R Drlg.

Well No. 1 Farm Elmore

Elev. 2383 Location SW SW SW

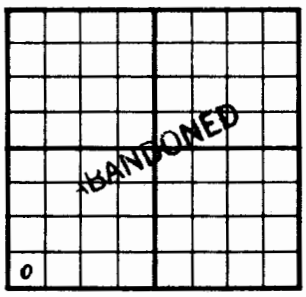

330 Ft. From S Line SW

330 Ft. From W Line Quarter

1st. Report

Completion NOV 14 1951

Remarks Wildcat

B & R Drlg. - Contr.

Spudding Date 9-29-51

Drlg. Data D & A TD 4883

8" @ 210 Anhy 1700 Heeb. 3761

KC 3792 B KC 4086 Cong. 4162

DST 4274-4317 open ½ hr. Rec. 160' mud

Miss. 4330 Arb. 4638 TD 4883

D & A

J. E. TYRA

FORM 252-B
10M 11-50 PETROL

Ness KANSAS

Sec. 8 Twp. 16 R. 21 W

Well No. # 1 Elmore Farm

B + R Drlg.
~~Ed Leben~~ Company

B & R Drlg. Contractor

Wildcat


Ft. from N. Line

330 Ft. from S. Line

Ft. from E. Line

330 Ft. from W. Line

SW SW SW

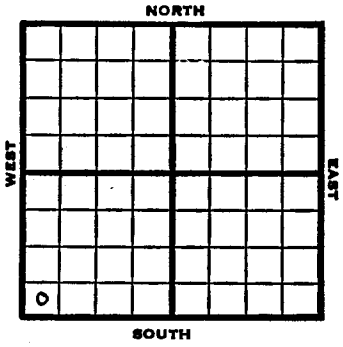

1951	Elev. 2383' REPORT
9/26 11/14	Location Spud 9-29-51 D & A TD 4883' 8" @ 210 Anhy 1700' Heeb 3761' KC 3792' B KC 4086' Cong. 4162' DST 4274-4317 open ½ hr. rec 160' mud Miss 4330' Arb. 4638' TD 4883' D & A ABANDONED

FORM 51 25M 8-50 WESTERN Ness KANSAS

Section 8 Township 16 Range 21 W

Well No. # 1 Elmore

Company Ed Leben

