

County <u>Ness</u> Elev. <u>2311 RB</u>				Co.
Sec. <u>9</u> Twp. <u>16</u> Rge. <u>21W</u>				
Company <u>Walch & Olsson Drlg.</u>				
Farm Name <u>Elmore</u> No. <u>1</u>				
TOPS	DEPTH	LOG	DATUM	Loc. in Sec.
Anh.	1620			NW NW SE
TP.				
H.				
Tr.				
Dg.				
BL.				
L.				Geol.
K.C.				Cont.
B.K.C.				Co. tools
Ce.				
C.				Pool
M.				Wildcat
M.				
K.				
Mz.				
Me.				
V.				
S.				
S.				
A.				
R.				
PE.				
G.				
TD.				

Geol. _____
Cont. _____
Co. tools _____
Pool _____
Wildcat _____

FIRST REPORT

AUG 22 '56

Date Comm. 8-17-56
8" @ 30 drlg. 2710

County <u>Ness</u> Elev. <u>2311 RB</u>				Co.
Sec. <u>9</u> Twp. <u>16</u> Rge. <u>21W</u>				
Company <u>Walch & Olsson Drlg.</u>				
Farm Name <u>Elmore</u> No. <u>1</u>				
TOPS	DEPTH	LOG	DATUM	Loc. in Sec.
Anh.	1620			NW NW SE
TP.				
H.				
Tr.				
Dg.				
BL.				
L.				Geol.
K.C.				Cont.
B.K.C.				Co. tools
Ce.				
C.				Pool
M.				Wildcat
M.				
K.				
Mz.				
Me.				
V.				
S.				
S.				
A.				
R.				
PE.				
G.				
TD.				

Geol. _____
Cont. _____
Co. tools _____
Pool _____
Wildcat _____

ABANDONED

SEP 5 '56

1/2 mile

Date Comm. 8-17-56
8" @ 30 drlg. 2710

D&T 4159-78 1 hr. rec. 20' Md
BHP 3/20" F579 SEP 5 '56 ✓

D&A.

Ness **KANSAS**

SEC. 9 TWP. 16 R. 21W

WELL NO. #1 Elmore

COMPANY Welch & Olsson Drlg.

CONTRACTOR Co. Tools

WILDCAT


FT. FROM N. LINE

FT. FROM S. LINE

FT. FROM E. LINE

FT. FROM W. LINE

NW NW SE

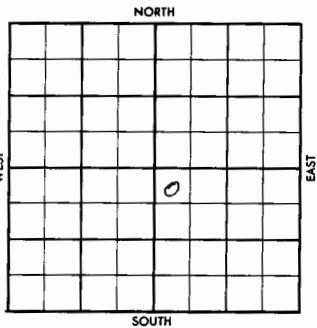

	ELEVATION	REPORT
1956	2311' RB	
8-22	Comm. 8-17-56 8" @ 230 Drlg. 2710'	
9-6	Heeb 3694, Tor 3716, Lans 3735, BKC 4016, Marm 4085, Ce sh 4143, Ce Sd 4153 DST 4159-78, open 1 hr rec 20' mud, 0/20" fishing D & A	

ABANDONED

DX 78-1 Ness **KANSAS**

Section 9 Township 16 Range 21W

Well No. #1 Elmore

Company Welch & Olsson Drlg

