FORM 513 REV. SUNRAY

County: Ness | Elev.:
Sec. 36 | Twp. 16 | Rge. 21W
Company: Sunray Mid-Continent
Farm Name: McMamee | No. 2

TOPS	DEPTH	LOG	DATUM
Anh.			
Tp.			
H.			
Tr.			
Dg.			
Bl.			
L.			
K.C.			
B.K.C.			
Ce.			
C.			
M.			
M.			
K.			
Mz.			
Mo.			
V.			
S.			
S.			
A			
R.			
P€.			
G.			
T.D.			

Loc. in Sec.: SE NW NE
Geol.:
Contr.: Stickle
Pool: Davenport

FIRST REPORT
DEC 14 '55

Date Comm. 12-8-55
8" @ 286/275 drlg. 2505

Co. | Lse. | No. | Sec. | T. | R.

FORM 513 REV. SUNRAY

County: Ness | Elev.: 2196 KB / 2193 DF
Sec. 36 | Twp. 16 | Rge. 21W
Company: Sunray Mid-Continent
Farm Name: McMamee | No. 2

TOPS	DEPTH	LOG	DATUM
Anh.			
Tp.			
H.	3563	3560	
Tr.	3582	3579	
Dg.			
Bl.			
L.	3604	3601	1408
K.C.			
B.K.C. Marm		3953	1760
Ce. Tarsh	4038		
C. 2nd Ce.sd	4051		
M.			
M.			
K.			
Mz.			
Mo.			
V.			
S.			
S.			
A	4136	4129	1936
R.			
P€.			
G.			
T.D.	4170		

Loc. in Sec.: SE NW NE
Geol.:
Contr.: Stickle
Pool: Davenport

COMPLETE
JAN 18 1956

Date Comm. 12-8-55
8" @ 286/275 DST 4052-63 open 1 hr.
rec. 3070' oil 1170# $5\frac{1}{2}$" @ 4169/150
CO to 4160 24/ 4052-58 FU 3000' oil
1 hr. Comp. 2862 bopd

Co. | Lse. | No. | Sec. | T. | R.

HOT FILE

Ness	KANSAS

SEC.	TWP.	R.
30	16 S	21 W

WELL NO.
2 McNamee FARM

COMPANY
Sunray Mid-Continent (DEVELOPMENT)

CONTRACTOR
Stickle Drlg. Co.

Davenport

990 Ft. from N. Line

Ft. from S. Line

Ft. from E. Line

990 Ft. from W. Line

of NE/4

SE NW NE

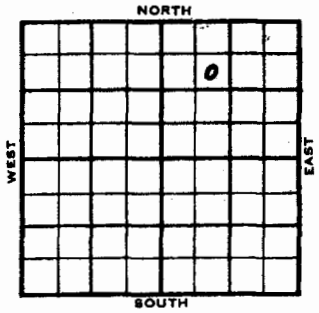

ELEVATION 2113 ?

REPORT

1955
Projected Cherokee-Arbuckle @ 4150'

12/9 8-5/8" @ 286 WOC
Drlg. 288' (DR #241)
Spud 12-8-55

12/12 Drlg. 2170'

12/13 Drlg. 2505' (FR Tkt)

12/14 Drlg. 2810'

12/15 Drlg. 3170'

12/16 Drlg. 3455'

12/19 Drlg. 3950'

12/20 Drlg. 4058'

12/21 Drlg. 4135'
DST #1, 4052-63, open 1 hr rec 3070'
42.4 gravity oil, no wtr. FFP 1065#.

12/22 TD 4170'. Rng 5½" csg.

12/23 TD 4170'. WOC - 5½" @ 4169'

12/27 TD 4170'. Prep to perforate

12/28 TD 4170'. Prep to pump. Perf 4052-58'

12/29 TD 4170'. Prep to pump

12/30 TD 4170' Installing pump equip.

1956

1/3 TD 4170'. Installing pump equip.

1/4 TD 4170'. Pumping.

1/5 TD 4170'. No test. Perfs 4052-58', Arbuckle Zone - COMPLETE 12-31-55

DX-76

OVER

1956

1-12 Taking state test.

1-18 8" @ 286/275
5½" @ 4169/150
CO to 4160,
24/ 4052-58
FU 3000' oil 1 hr.
Comp. 2862 bopd

H.	3563	3560
Tr.	3582	3579
L.	3604	3601
Marm		3953
Lst sh.	4038	
2nd Ce Sd.	4051	
A.	4136	4129

TD 4170'

COMPLETED

Ness

KANSAS

SECTION 36 TOWNSHIP 16 RANGE 21 W

WELL NO. #2 McMames

COMPANY ~~Sunray Mid-Continent~~

NORTH

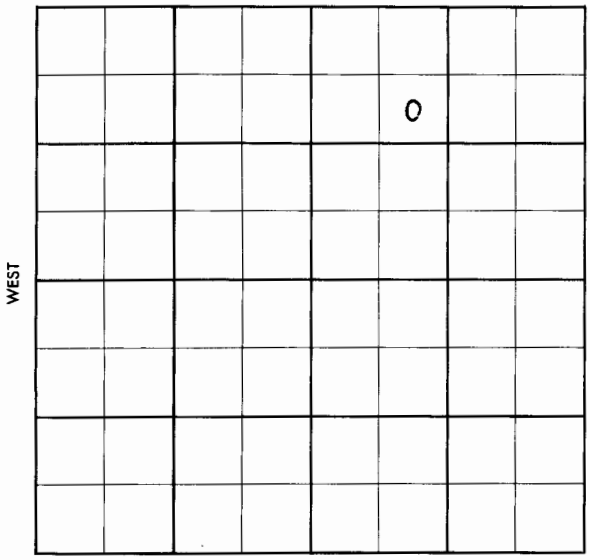

2

WEST

EAST

SOUTH

FORM 504-3 SUNRAY