

S-513-B

18
O.W.W.O.

Davenport

County ~~Neesh~~ Elev. 2165
 Sec. 36 Twp. 16 Rge. 21W
 Company ~~Sunray Mid-Continent~~ (was Aurora)
 Farm Name Herdman No. 1

TOPS	DEPTH	LOG	DATUM
Anh.			
Tp.			
H.	3576		
Tr.	3585		
Dg.			
B.L.			
L.	3589		
K.C.			
B.K.C.	3856		
Ce.	4001		
C.	4050		
M.			
M.			
K.			
Mz.			
Ma.			
V.	4108		
S.			
S.			
A.			
R.			
Pf.			
G.			
T.D.	4168		

Loc. in Sec. NE NE SW
O.W.W.O.
 Geol. _____
 Contr. _____
 Pool _____

FIRST REPORT
 JAN 22 '58
 COMPLETE

Date Comm. OTD ?
wash down at 3000' DD 4/468
5" @ 4183/250 C^U to 4168 FU 1200' wtr.
S/ 60 bwph P/ 100 bwph
Comp. SWD well


JAN 24 1958
 M. M.

O. W. D. D. **Ness** **KANSAS**
 SEC. **FILE** TWP. **16 S** R. **21 W**

WELL NO. **# 1-SWD Herdman** FARM

COMPANY **Sunray Mid-Continent (DEVELOPMENT)**
 (was Aurora)
 CONTRACTOR **Stickle Drlg.**

Davenport Field.

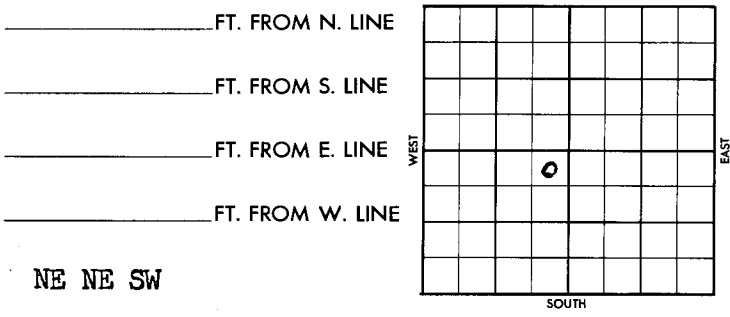

1958 ELEVATION **2165'** REPORT

O. W. D. D. (FR & Comp tkt.)

1/3 TD 4121'
 Washing hole down @ 3000' (DR#2-58)

1/6 Drlg. 4460'

1/7 TD 4468'. WOC. 5 1/2" @ 4183'

1/8 TD 4468'. WOC. 5 1/2" csg.

~~1/9~~ TD 4468'. " "

1/10 TD 4468'. Drlg. float collar @ 4146'

1/13 TD 4468'. SWD Well
 Open hole 4183-4468'
 Arbuckle Zone. Complete (DR#8-58)

1/22 Wash down @ 3000' DD 4468'
 5" @ 4183/250 CO to 4468'
 FU 1200' wtr. S/60 BWPB
 P/100 BWPB TD 4468' Comp. SWD well
 Tops: H. 3546', Tr 3565', L. 3589'
 BKC 3856', Ce 4001', C 4050', V. 4108'
 (Scout FR & Completion Ticket)

FIRST REPORT
COMPLETED

OWWO **Ness** **KANSAS**

SECTION **36** TOWNSHIP **16S** RANGE **21W**

WELL NO. **#1 Herdman**

COMPANY **Sunray Mid-Continent Oil Co.**

