

County Ness				Elev.	
Sec. 16	Twp. 16	Rge. 24W			
Company Ohio Oil					
FarmName Miller No. 1					
TOPS	DEPTH	LOG	DATUM	Loc. in Sec.	
Anh.				C SE NE	
Tr.					
H.					
Dg.					
Bl.					
L.					
K.C.				Geol.	
B.K.C.				Contr.	
Ce.				H & H Drlg.	
C.					
M.				Pool	
M.				Wildcat	
K.					
Mz.					
Ma.					
V.					
S.					
S.					
A.					
R.					
Pe.					
G.					
FIRST REPORT DEC 21 '55					
Date Comm. 12-18-55					
10" @ 350/300 WOC					

County Ness				Elev.	2530
Sec. 16	Twp. 16	Rge. 24W			
Company Ohio Oil					
FarmName Miller No. 1					
TOPS	DEPTH	LOG	DATUM	Loc. in Sec.	
Anh.				C SE NE	
Tr.					
H.	3878	3876			
Dg.	3894				
Bl.					
L.	3917	3917	1387	Geol.	
K.C.				Contr.	
B.K.C.	4238	4228	1698	H & H Drlg.	
Ce.	4420	4418	1888		
C.	4488	4488	1958	Pool	
M.	4526	4526	1996	Wildcat	
M.					
K.					
Mz.					
Ma.					
V.					
S.					
S.					
A.					
R.					
Pe.					
G.					
ABANDONED					
Date Comm. 12-18-55 JAN 18 1956					
10" @ 350/300 DST 4427-32 open 1 hr.					
rec. 45' mud 30"					
D & A					

Ness

KANSAS

SEC. 16	TWP. 16	R. 24W
------------	------------	-----------

WELL NO.

#1 Miller

FARM

COMPANY

Ohio Oil

CONTRACTOR

H & H Drlg.

WILDCAT


Ft. from N. Line

Ft. from S. Line

Ft. from E. Line

Ft. from W. Line

C SE NE

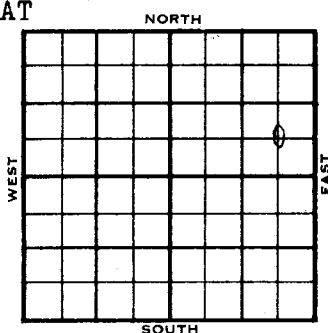

	ELEVATION	REPORT
1955	2530'	
12-21	Comm. 12-18-55 10" @ 350/300 WOC	
1956		
1-18	DST 4427-32 op 1 hr. rec. 45' mud, 30" D & A H. 3878 3876 Tr. 3894 L. 3917- 3917 ## BKC 4228 Marm 4238 Ft. Scott 4420 4418 M.Ce. 4488 4488 M. 4526 4526 TD 4626'	
ABANDONED		

DX-78

Ness

KANSAS

SECTION 16	TOWNSHIP 16	RANGE 24 W
---------------	----------------	---------------

WELL NO. #1 Miller

COMPANY Ohio Oil

NORTH

