



County **Noss** Elev. **4585 DF**  
 Sec. **20** Top **16** Sp. **25W**  
 Company **Walsh & Olson**  
 Farm Name **Michaelis** No. **1**

TOPS	DEPTH	LOG	DATE	Loc. in Sec.
				SWSE
Asph.				
TP				
H	3261			
T	3220			
Sp				
Bl				
L	3201	1316		Geol.
KC				
REC	4260	1675		Co. tools
Co. 1st set	4411	1826		
C	4425	1900		
M	4491	1906		
R	D110 4520	1925		Pool
K				Wildcat
Sh				
W				
V				
E				
S				
A				
R				
PE				
O				
SA	4575			

Date Comm. **Carter AC**  
**MIR JAN 25 '56** 1-187 26 8 1/8  
 137/150 10.3440 FEB 1 '56  
 DST 4413-39 30" 30' Md  
 FP 0-0 BHP 900/30" DST 4488  
 -4503 30" 30' Md 13197  
 0/30" DST 4503-30 1hr. acc.  
 30' Md 13197 1000/60 FEB 8 '56 DST  
 4520-44 30" 30' Md 13HP  
 1300/60 DST 4544-65 90"

see 230' SW BHP 1150/60

*Handwritten signature*

R.G.  
FEB 22 1956

FEB 8 1956  
 ABANDONED  
 0

Ness

KANSAS

SEC.	TWP.	R.
20	16	25W

WELL NO.

#1 Michaelis

FARM

COMPANY

Welch & Olsson

CONTRACTOR

Co. Tools

WILDCAT


\_\_\_\_\_ Ft. from N. Line

\_\_\_\_\_ Ft. from S. Line

\_\_\_\_\_ Ft. from E. Line

\_\_\_\_\_ Ft. from W. Line

SW SW SE

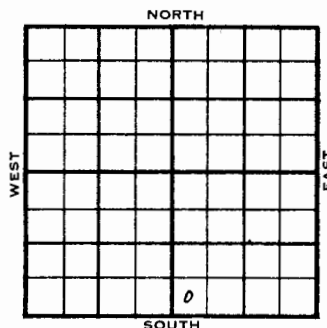

Carter AC

1956	ELEVATION 2585 DF, 2587 RB	REPORT
1-18	MIR	
2-8	Comm. 1-8-56 8 5/8" @ 137 w/150 ED & A H. 3861 Tr. 3880 L. 3901 BKC 4260 Ft Set. 4411 C. 4485 M. 4491 M.Dolo 4520 TD 4575'	
		ABANDONED
DX-78		