

KANSAS Kansas Pool Name Wildcat
 Map No. 77 Sec. 23 Twp. 16 R. 25W
 Well No. 1 Holly Cross

Sohie

Company


FIRST REPORT

Contractor

C SW SW

SECTION PLAT

Ft. from N. Line
660 Ft. from S. Line
 Ft. from E. Line
660 Ft. from W. Line

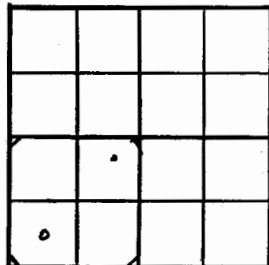

Ness County

Location X

RECORD

Cased _____ in. _____ ft.
 Sand _____
 Gas _____
 Oil _____
 Total Depth _____

PRODUCTION

1st 24 hrs. Nat. _____
 1st 24 hrs. after shot _____
 Gas _____ Cu. Ft.
 Dry Hole _____
 Abandoned _____

Date

JAN 9 1946

19

S. J. LEWIS

Scout

KANSAS Kansas Pool Name Arnold
 Map No. 77 Sec. 23 Twp. 16 R. 25W
 Well No. 1 Holy Cross

Sohie

Company


COMPLETED

Contractor

C SW SW

SECTION PLAT

Ft. from N. Line
660 Ft. from S. Line
 Ft. from E. Line
660 Ft. from W. Line

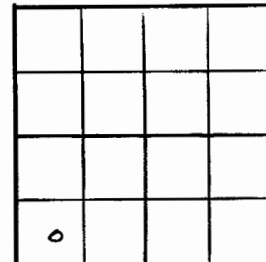

Ness County

Location _____

RECORD

Rig up _____
 Drilling and Remarks:

Miss 4583
5" C 4583
5000 cc oil
Pump 1500 ft
36 2/3

Cased _____ in. _____ ft.
 Sand _____
 Gas _____
 Oil _____
 Total Depth 4548

PRODUCTION

1st 24 hrs. Nat. _____
 1st 24 hrs. after shot _____
 Gas _____ Cu. Ft.
 Dry Hole _____
 Abandoned _____

Date

MAR 20 1946

19

S. J. LEWIS

Scout

KANSAS

Ness County

Sec. 23 Twp. 16 R. 25WWell No. #1 Holly Cross Farm

Sohio

Company

Wildcat


_____ Ft. from N. Line

660 _____ Ft. from S. Line

_____ Ft. from E. Line

660 _____ Ft. from W. Line

C SW SW

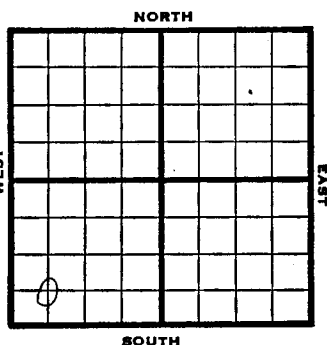

Elev. 2571' REPORT

1946

1/9 Location
1/17 10" - 313' Drlg. 2155'
1/24 Drlg. 3490'
1/31 Drlg. 3985'
2/7 Cong. 4496' Miss. 4533'
5" - 4533' T.D. 4537' RUST.
2/14 Drlg. 4540' SSO.
2/21 T.D. 4549' 5000 acid. Swab 40 oil per
hour 8 hours.

2/28 " "
3/7 " "
3/14 " "

3/20 Miss. 4533
5" @ 4533
5000 acid.
TD 4549'
Pump 1508 Pot.
Grav. 36.0

COMPLETED

KANSAS

Ness

Section 23 Township 16 Range 25-WWell No. #1 Holly CrossCompany Sohio