


County Lane State Kansas
 Sec. 16 (Blk. 16 (Sur. 28W Map No.
 Operator Murfin Drlg.
 Well No. 1 Farm Bailor
 Elev. SE SE SE Location

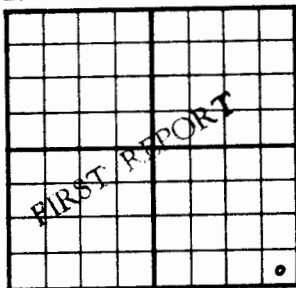


330 Ft. From S Line SE
330 Ft. From E Line Quarter
 Ist. Report NOV 19 1952
 Completion
 Remarks Gulf - support
Murfin Drlg. - Contr.
 Spudding Date

Drlg. Data

WildcatCellar & pits

J. G. McGEHEE

County Lane State Kansas
 Sec. 16 (Blk. 16 (Sur. 28W Map No.
 Operator Murfin Drlg.
 Well No. 1 Farm Bailor
 Elev. 2637 Location SE SE SE

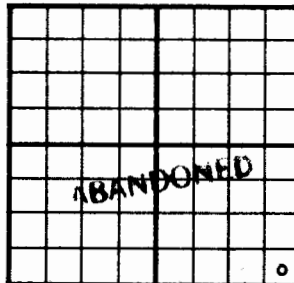

330 Ft. From S Line SE
330 Ft. From E Line Quarter
 Ist. Report
 Completion JAN 7 1953
 Remarks Wildcat
Murfin Drlg. - Contr.
 Spudding Date 12-5-52

Drlg. Data

D & ATD 45858" @ 257 Anhy 1530 Heeb. 3861Lans. 3896 B KC 4185 Cong. 4467Miss. 4484 TD 4487 DST 4465-4513open 3/4 hr. Rec. 20' mud 175# TD 4585D & A

J. G. McGEHEE

Lane

KANSAS


Sec. 16 Twp. 16 R. 28WWell No. #1 Bailor FarmMurfin Drlg. CompanyMurfin Drlg. Contractor

Wildcat

Ft. from N. Line

330 Ft. from S. Line330 Ft. from E. Line

Ft. from W. Line

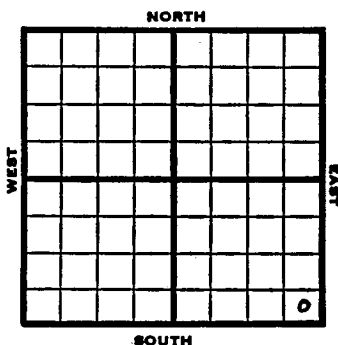SE $\frac{1}{4}$ SE SE SE
Gulf - Support

1952 Elev. 2687' REPORT

11/19 Cellar & Pits
11/27 "

12/4 "

12/11 Ø1947

12/18 Ø3643

12/25 Drlg. 3643

1953

1/7

Spud 12-5-52 D & A TD 4585'

8" @ 257 Anhy 1530' Heeb 3861'

Lans. 3896' B KC 4185' Cong. 4467'

Miss 4484' TD 4487'

DST 4465-4513 open 3/4 hr. rec 20' mud

175# TD 4585' D & A

ABANDONED

Lane

KANSAS

Section 16 Township 16 Range 28 WWell No. # 1 BailorCompany Murfin Drlg.