

KANSAS DRILLERS LOG


State Geological Survey

WICHITA, BRANCH

API No. 15 — 101
County20,150
NumberS. 25 T. 16 R. 28 ^E_W

Loc. C NE NW

County Lane

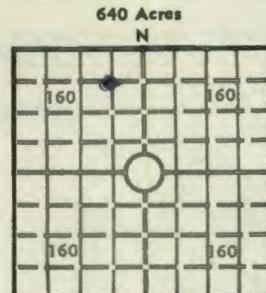

Elev.: Gr. 2748

DF 2748 KB 2751

Operator

Gabbert-Jones, Inc.

Address 830 Sutton Place Wichita, Kansas 67202

Well No. #2 Lease Name Thorne

Footage Location

feet from (N) (S) line

feet from (E) (W) line

Principal Contractor GABBERT-JONES, INC.

Geologist

ELDON SCHTERLING

Spud Date

Total Depth

P.B.T.D.

January 18, 1976

4650

Date Completed

Oil Purchaser

January 30, 1976

DRY HOLE

CASING RECORD

Report of all strings set—surface, intermediate, production, etc.

Purpose of string	Size hole drilled	Size casing set (in O.D.)	Weight lbs/ft.	Setting depth	Type cement	Sacks	Type and percent additives
surface	12 1/4	8 5/8	28#	341	Common	200 sk	2% Gel, 3% CC

LINER RECORD

PERFORATION RECORD

Top, ft.	Bottom, ft.	Sacks cement	Shots per ft.	Size & type	Depth interval

TUBING RECORD

Size	Setting depth	Packer set at		

ACID, FRACTURE, SHOT, CEMENT SQUEEZE RECORD

Amount and kind of material used			Depth interval treated

INITIAL PRODUCTION

Date of first production		Producing method (flowing, pumping, gas lift, etc.)				
RATE OF PRODUCTION PER 24 HOURS	Oil bbls.	Gas MCF	Water bbls.	Gas-oil ratio	CFPB	
Disposition of gas (vented, used on lease or sold)					Producing interval(s)	

INSTRUCTIONS: As provided in KCC Rule 82-2-125, within 90 days after completion of a well, one completed copy of this Drillers Log shall be transmitted to the State Geological Survey of Kansas, 4150 Monroe Street, Wichita, Kansas 67209. Copies of this form are available from the Conservation Division, State Corporation Commission, 3830 So. Meridian (P.O. Box 17027), Wichita, Kansas 66217. Phone AC 316-522-2206. If confidential custody is desired, please note Rule 82-2-125. Drillers Logs will be on open file in the Oil and Gas Division, State Geological Survey of Kansas, Lawrence, Kansas 66044.

Operator

GABBERT-JONES, INC.

DESIGNATE TYPE OF COMP.: OIL, GAS,
DRY HOLE, SWDW, ETC.:

Well No.

2

Lease Name

THORNE

DRY HOLE

S 25 T 16 R 28 ~~EX~~
W

WELL LOG


Show all important zones of porosity and contents thereof; cored intervals, and all drill-stem tests, including depth interval tested, cushion used, time tool open, flowing and shut-in pressures, and recoveries.

SHOW GEOLOGICAL MARKERS, LOGS RUN,
OR OTHER DESCRIPTIVE INFORMATION.

FORMATION DESCRIPTION, CONTENTS, ETC.	TOP	BOTTOM	NAME	DEPTH
Surface clay-shale	0	40		
Post rock-shale-sand	40	345		
Shale	345	1600		
Shale-redbed	1600	2145		
Shale lime	2145	2163		
Anhydrite	2163	2202		
Shale-lime	2202	3245		
Lime shale	3245	4005		
Lime	4005	4258		
Lime-shale	4258	4310		
Lime	4310	4650		

USE ADDITIONAL SHEETS, IF NECESSARY, TO COMPLETE WELL RECORD.

Date Received

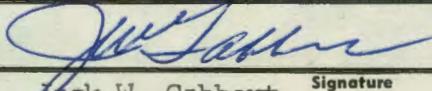Jack W. Gabbert
Exec. Vice President

Signature

Title

June 1, 1976

Date

GABBERT-JONES, INC.
WICHITA, KANSAS
DRILLERS' WELL LOG

25-16-28W

15-101-20150

State Geological Survey
WICHITA, KANSAS

Thorne #2
C-NE-NW Sec 25-16S-28W
Lane County Kansas

Commenced: 1-18-76

Completed: 1-30-76

OPERATOR: GABBERT-JONES, INC.

From	To	Depth	Formation	Remarks
0	40		Surface Clay- Shale	
40	345		Post Rock-Shale-Sand	Ran 8 jts of 28# 8 5/8" csg
345	1600		Shale	set @ 341' Cemented w/
1600	2145		Shale-Redbed	200 sks Common 2% Gel
2145	2163		Shale-Lime	3% CC PD @ 10:55 p.m.
2163	2202		Anhy	1-18-76
2202	3245		Shale-Lime	
3245	4005		Lime-Shale	
4005	4258		Lime	
4258	4310		Lime-Shale	
4310	4650		Lime	
				DRY & ABANDONED

I, James S. Sutton II, certify this is a correct copy of the Drillers' Log for the well drilled C-NE-NW, Sec 25-16S-28W, Lane County, Kansas to the best of my knowledge and belief.

STATE OF KANSAS)
) SS
COUNTY OF SEDGWICK)

Before me, the undersigned, a Notary Public within and for said County, State, on this 25th day of March 1976, personally appeared James S. Sutton II to me personally known to be the identical person who executed the within and foregoing instrument and acknowledged to me that he executed the same as his free and voluntary act and deed for the uses and purposes therein set forth.

IN WITNESS WHEREOF, I have hereunto set my hand and official seal the day and year last above written.

Elizabeth J. Edwards
ELIZABETH J. EDWARDS-NOTARY PUBLIC

My Commission Expires: February 6, 1979.

