

Pool Name WildcatMap No. N/M Sec. 25 Twp. 16 R. 29WWell No. 1 JamesSkelly

Company

FIRST REPORT

Contractor

NE/C

SECTION PLAT

330

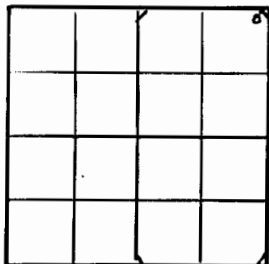
Ft. from N. Line

Ft. from S. Line

330

Ft. from E. Line

Ft. from W. Line

LaneLocation X

RECORD

Cased in ft.

Sand

Gas

Oil

Total Depth

PRODUCTION

1st 24 hrs. Nat.

1st 24 hrs. after shot

Gas Cu. Ft.

Dry Hole

Abandoned

Pool Name WildcatMap No. N/M Sec. 25 Twp. 16 R. 29WWell No. 1 JamesSkelly

Company

ABANDONED

Contractor

NE/c

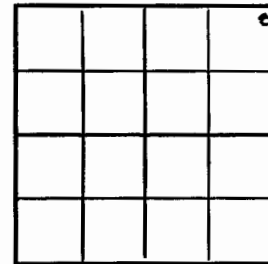
SECTION PLAT

330 Ft. from N. Line

Ft. from S. Line

330 Ft. from E. Line

Ft. from W. Line

Lane

Location

RECORD

Cased in ft.

Sand

Gas

Oil

Total Depth 5292

PRODUCTION

1st 24 hrs. Nat.

1st 24 hrs. after shot

Gas Cu. Ft.

Dry Hole

Abandoned

Wire 4574CR 4945

Date

JAN 10 1945 19S. J. LEWIS Scout

Date

CT 11 1944 19 S. J. LEWIS Scout

KANSAS

Lane County

Sec. 25 Twp. 16 R. 29W

Well No. #1 James Farm

Skelly Company

Wildcat

330 Ft. from N. Line

Ft. from S. Line

330 Ft. from E. Line

Ft. from W. Line

Wildcat Elev. 2782

REPORT

1944

10/11 Loc.

10/18 "

10/25 "

11/2 "

11/8 "

11/16 ROR

11/24 1220 run 10"

11/29 10" @ 1140 Drlg. 1900'

12/6 Drlg. 2855'

12/14 Drlg. 2870'

12/21 Drlg. 3010

12/29 Drlg. 3505

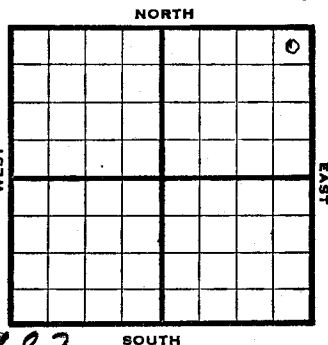
1945

1/10 Miss 4574

Arb. 4945

TD 5032

ABANDONED



KANSAS

Lane County

Section 25 Township 16 Range 29W

Well No. #1 James

Company Skelly

