


5-16-3W

WELL LOG BUREAU—KANSAS GEOLOGICAL SOCIETY
508 East Murdock, Wichita, Kansas

Company- PHILLIPS & SANDERSON
Farm- H. T. Johnson "A" No. 1

SEC. 5 T. 16 R. 3W
SW SW NE

Total Depth. 3371 K.B.
Comm. 11-19-52 Comp. 12-7-52
Shot or Treated.
Contractor. E. K. Carey
Issued. 11-21-53

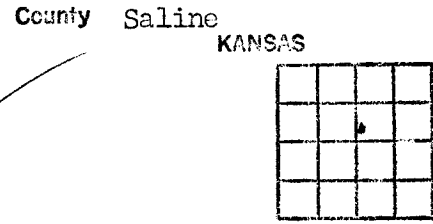

CASING:
8 5/8" 316' cem w/250 sx
4 1/2" 3365' cem w/ 75 sx

Production. 120 bbls / VSSW

Figures Indicate Bottom of Formations. K.B.

cellar 8
clay, shale 65
shale, shells 265
lime, shale 385
lime 505
lime, shale 890
lime 943
shale, lime 1110
shale, shells 1480
lime, shale 1955
lime 2040
shale, lime 2210
lime 2554
shale, lime 2842
lime 3125
lime, shale 3185
shale 3365
lime 3371
Total Depth RTD

Tops:
Miss. 2839
Kinderhook 3128
Shaly Misener 3294
Maquoketa shale 3295
Maquoketa dolomite 3364

pay 3364-71

4 1/2" casing set 6' off bottom
3365'

DST 3365-3371, 6' anchor, open
1 hr. 15 min., started w/light
blow, increased to strong blow in
10 min., after 60 min. blow decreased
and was dead in 1 hr. and 15 min.
Recovered 8' oil cut mud, 60' heavy
oil cut mud, 60' free oil & no water,
15 min. BHP 1240# I.F.P. 10# F.F.P 55#