

SIDE ONE

STATE CORPORATION COMMISSION OF KANSAS
OIL & GAS CONSERVATION DIVISION

WELL COMPLETION OR RECOMPLETION FORM
ACO-1 WELL HISTORY

DESCRIPTION OF WELL AND LEASE

Operator: License # 5181
Name DONALD C. SLAWSON
Address 200 Douglas Building
City/State/Zip Wichita, Kansas 67202

Purchaser.....

Operator Contact Person Bill Horigan
Phone (316) 263-3201

Contractor: License # 5657
Name SLAWSON DRILLING CO., INC.

Wellsite Geologist Charles Spradlin
Phone (316) 683-0668

Designate Type of Completion

☒ New Well ☐ Re-Entry ☐ Workover

☐ Oil ☐ SWD ☐ Temp Abd
☐ Gas ☐ Inj ☐ Delayed Comp.
☒ Dry ☐ Other (Core, Water Supply etc.)

If OWO: old well info as follows:

Operator
Well Name
Comp. Date Old Total Depth.....

WELL HISTORY

Drilling Method:

☒ Mud Rotary ☐ Air Rotary ☐ Cable

12/3/85 12/15/85 12/15/85
Spud Date Date Reached TD Completion Date

4540'
Total Depth PBTD

Amount of Surface Pipe Set and Cemented at 383 feet
Multiple Stage Cementing Collar Used? ☐ Yes ☐ No

If yes, show depth set.....feet

If alternate 2 completion, cement circulated
from.....feet depth to.....w/.....SX cmt

API NO. 15-101-21,252.....

County Lane.....

NE NE SW Sec. 14 Twp. 16 Rge. 30 ☐ East
☒ West

2300 Ft North from Southeast Corner of Section
3010 Ft West from Southeast Corner of Section
(Note: Locate well in section plat below)


Lease Name Watt V Well # 1

Field Name Wildcat

Producing Formation.....

Elevation: Ground 2756 KB 2762

Section Plat

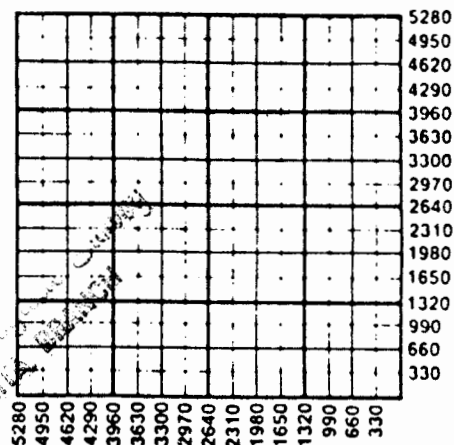

WATER SUPPLY INFORMATION

Disposition of Produced Water: ☐ Disposal
Docket # ☐ Repressuring

Questions on this portion of the ACO-1 call:

Water Resources Board (913) 296-3717

Source of Water:

Division of Water Resources Permit #.....

☐ Groundwater.....Ft North from Southeast Corner
(Well)Ft West from Southeast Corner of
Sec Twp Rge ☐ East ☐ West

☐ Surface Water.....Ft North from Southeast Corner
(Stream, pond etc).....Ft West from Southeast Corner
Sec Twp Rge ☐ East ☐ West

☐ Other (explain).....
(purchased from city, R.W.D. #)

INSTRUCTIONS: This form shall be completed in duplicate and filed with the Kansas Corporation Commission, 200 Colorado Derby Building, Wichita, Kansas 67202, within 90 days after completion or recompletion of any well. Rule 82-3-130 and 82-3-107 apply.

Information on side two of this form will be held confidential for a period of 12 months if requested in writing and submitted with the form. See rule 82-3-107 for confidentiality in excess of 12 months.

One copy of all wireline logs and drillers time log shall be attached with this form. Submit CP-4 form with