


# RUPE OIL COMPANY

P.O. BOX 2273 · 434 OHIO, WICHITA, KANSAS 67201 · (316) 262-3748

VONDRA "Gas Unit" - East Half (E/2) of Section 16

TOWNSHIP 16 South RANGE 7 West COUNTY Ellsworth STATE Kansas = 320 Acres

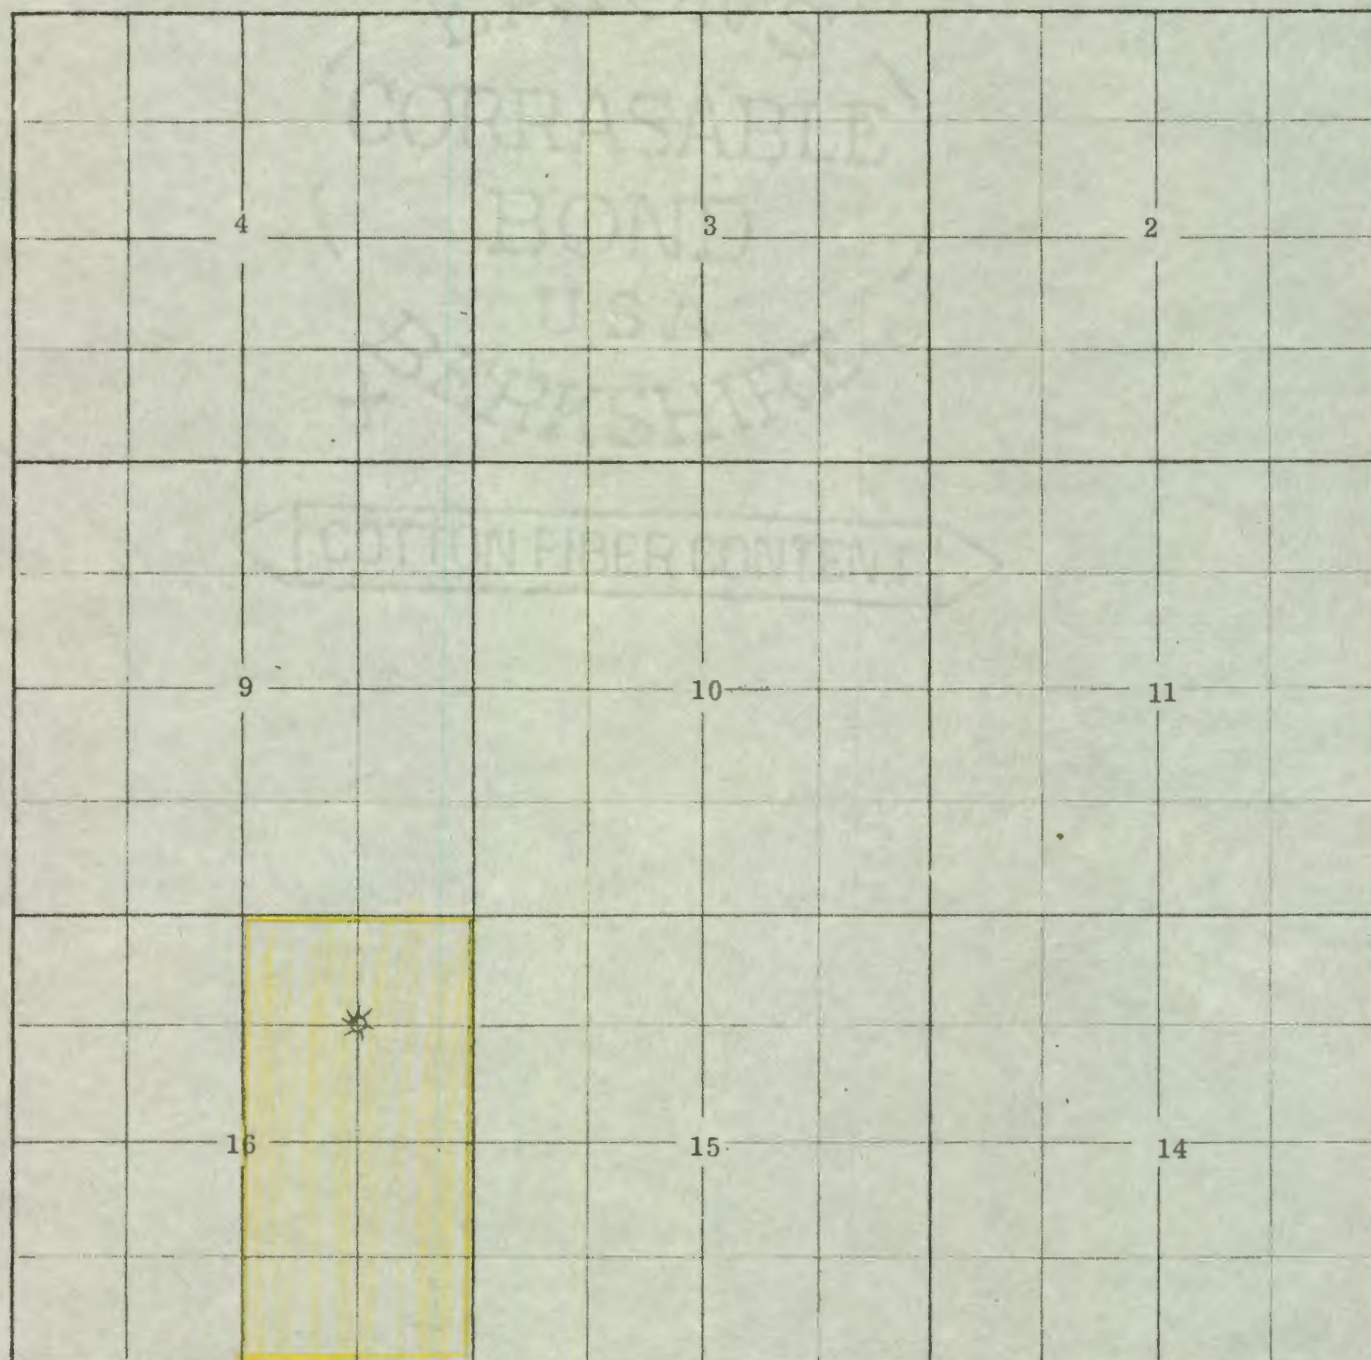

Lse #	Owner	Location	Acres	Expiring
#689	Charles Vondra	NE/4 of Section 16-16S-7W	160 Acres	11/8/77
#687	George Reed	SE/4 of Section 16-16S-7W	160 Acres	10/7/77
			320 Acres	

(subject to override of 1/16thx7/8ths in favor of R. C. Leake -- Leake to  
 dated 7/5/73) John Stone 1/2x1/16x7/8th  
 Mary S. Tasseff "  
 dated 4/4/78

#1 CHARLES VONDRA - C NE/4 of Section 16-16S-7W, Ellsworth County, Kansas  
 set pipe 8/6/73 and completed 8/21/73, on line 11/10/80/

Plugged 2/27/86


Gas Purchaser: Northern Natur

- Eff. 10/1/83 - Ralph H. Miller assigned his 8/32nds or 1/4th to G. N. Rupe in Vondra 'Gas Unit'
- Eff. 1/1/84 - Coors of Kansas, Inc./R. D. Hubbard assigned interest to G.N. Rupe
- Eff. 1/1/84 - Paul Royer assigned interest to G.N. Rupe
- Eff. 1/1/84 - Keith H. Jones assigned interest to G.N. Rupe.

UNITIZED September 27, 1977

VONDRA "Gas Unit" - East Half (E/2) of Section 16

TOWNSHIP 16 South RANGE 7 West COUNTY Ellsworth STATE Kansas = 320 Acres

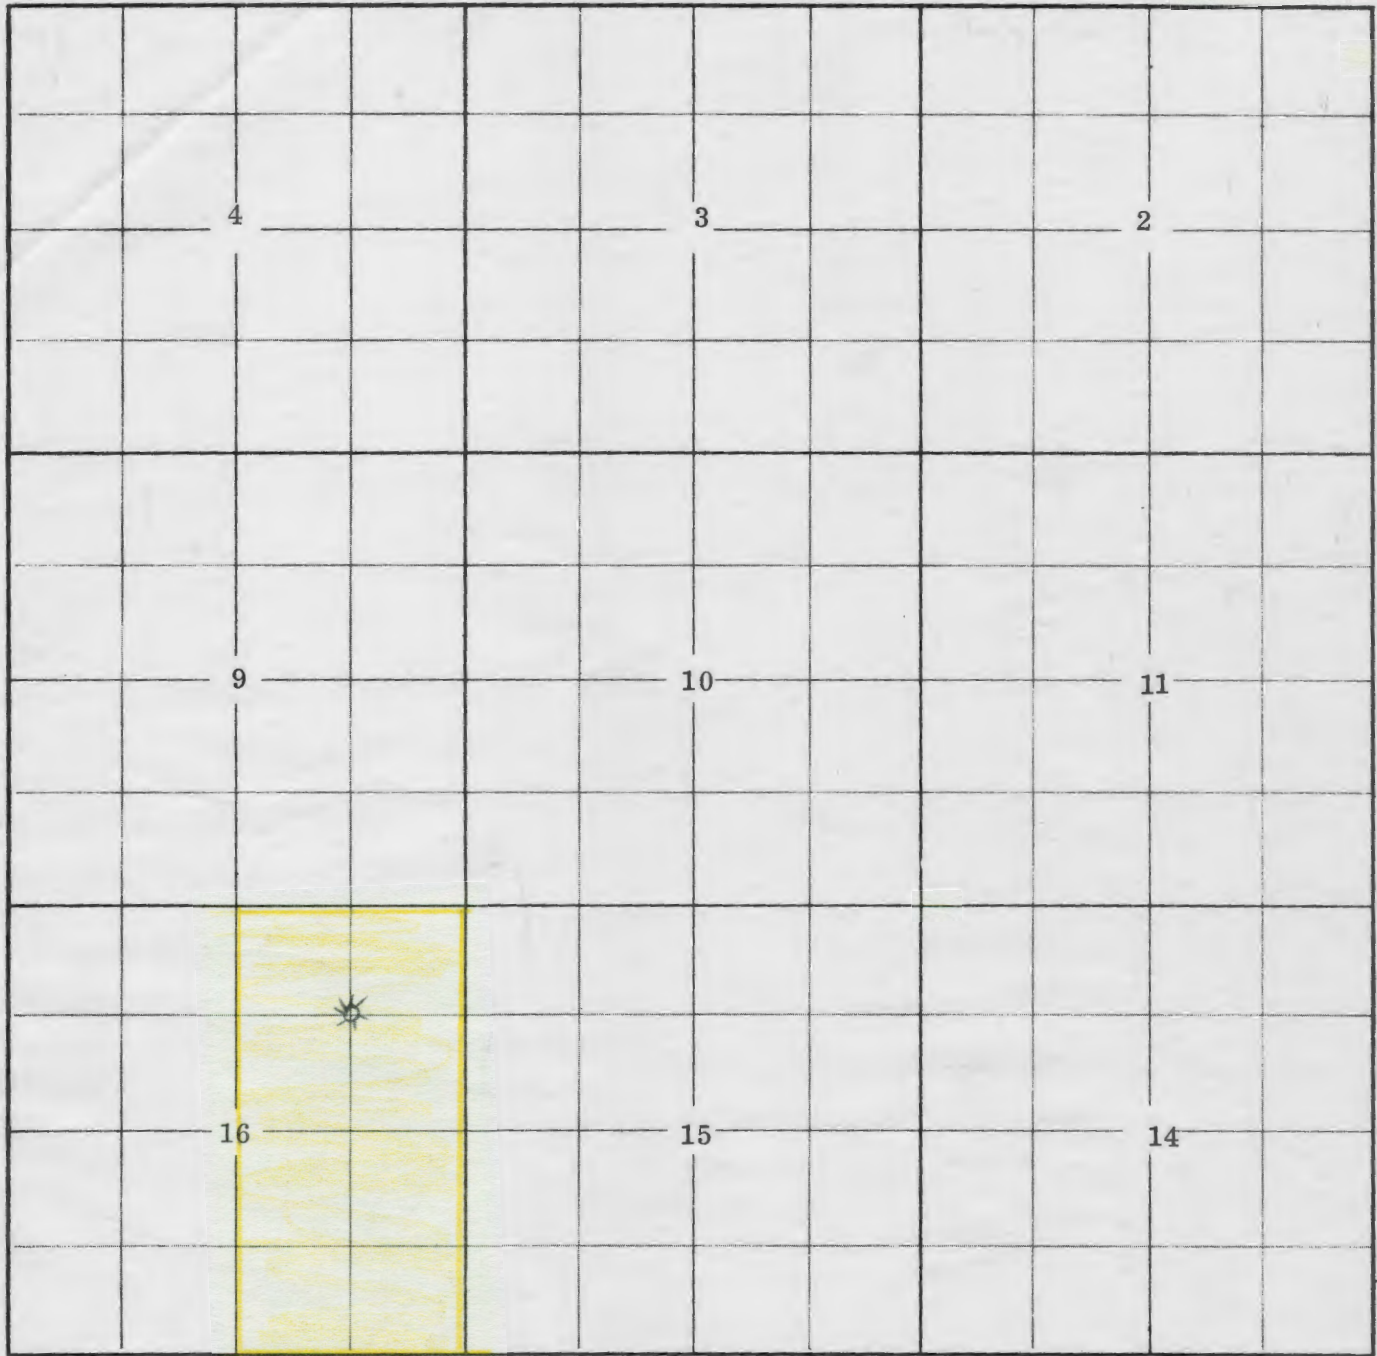

Lse #689 - Charles Vondra - NE/4 of Section 16-16S-7W

160 Acres

Expiring *leabe*  
11/8/77 *and on*

Lse #687 - George Reed - SE/4 of Section 16-16S-7W

160 Acres

10/7/77 ✓ ✓

320 Acres

1 CHARLES VONDRA - C NE/4 of Section 16-16S-7W, Ellsworth County, Kansas  
set pipe 8/6/73 and completed 8/21/73

61 copy 11/1/73