

LAUGHLIN-SIMMONS & CO. OF KANSAS, INC.
OILWELL ELEVATIONS AND LOCATIONS
2121 W. 18TH STREET (316) 943-5351
WICHITA, KANSAS 67203

9-20-74

DATE

Ellsworth 10 16s 7w
COUNTY S T R

900' FSL 1100' FWL SW/4

LOCATION

Glen Rupe

1

Gilkison

OPERATOR

NO.


FARM

ELEVATION: 1546 Cr

Mr. Glen N. Rupe
925 Olive Garvey Building
Wichita, Kansas 67202

REC'D SEP 4 1974

SCALE: 2" = 1 Mile

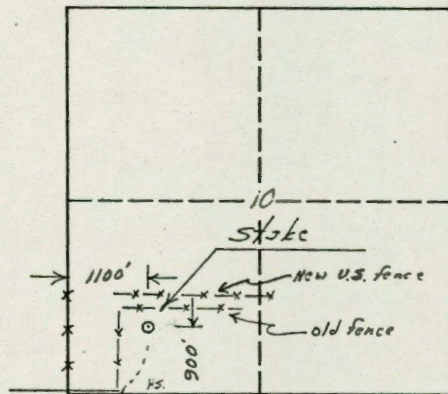

5' wood stake & flagging
Level plowed wheat
stubble
240'S of old E-W fence
Appx 400'S of new govt.
fence.

9-19-74

"need to dig pits on Friday 9-20-74" Mr. Clements
\$60.00

MINIMUM STAKING CHARGE:
(INCLUDES GROUND ELEVATION)

EXTRA TIME & MILEAGE:

ELEVATION CHARGE:

TOTAL:

45.00 (Special Trip
for Friday Stk.)

\$105.00

Thank you,
R. E. Moser

L-S ENGINEER

Laughlin-Simmons & Co. of Kansas, Inc. is not liable in case of errors and/or omissions.

Copy