

LAUGHLIN-SIMMONS & CO. OF KANSAS, INC.
 OILWELL ELEVATIONS AND LOCATIONS
 2121 W. 18TH STREET (316) 943-5351
 WICHITA, KANSAS 67203

2-16-75

✓ DATE


Ellsworth 16 16s 7w C NW/4
 COUNTY S T R LOCATION

Glen Rupe 2 Kroboth
 OPERATOR NO. FARM

ELEVATION: 1541 Gr.

Mr. Glen N. Rupe
 925 Olive Jarvey Building
 Wichita, Kansas 67202

REC'D FEB 20 1976

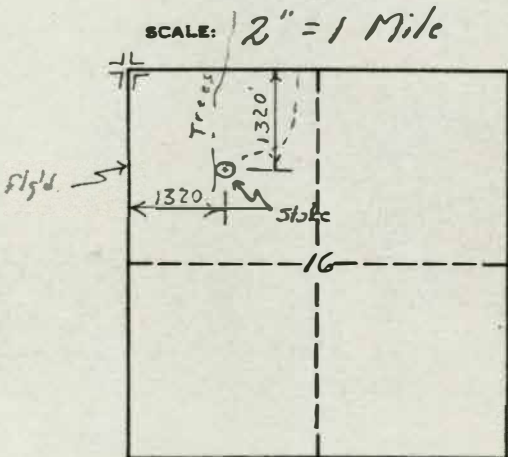

5' Rod - 1' wood stake
 slightly sloping
 wheat field 50' from
 shallow gully.

MINIMUM STAKING CHARGE: \$65.00
 (INCLUDES GROUND ELEVATION)

EXTRA TIME & MILEAGE: _____

ELEVATION CHARGE: _____


TOTAL: \$65.00

Thanks,
R. E. Moser
 L-S SURVEYOR

10
3000

2 - KROBOTH

TOWNSHIP 16 S RANGE 7 W COUNTY Ellsworth STATE Kans

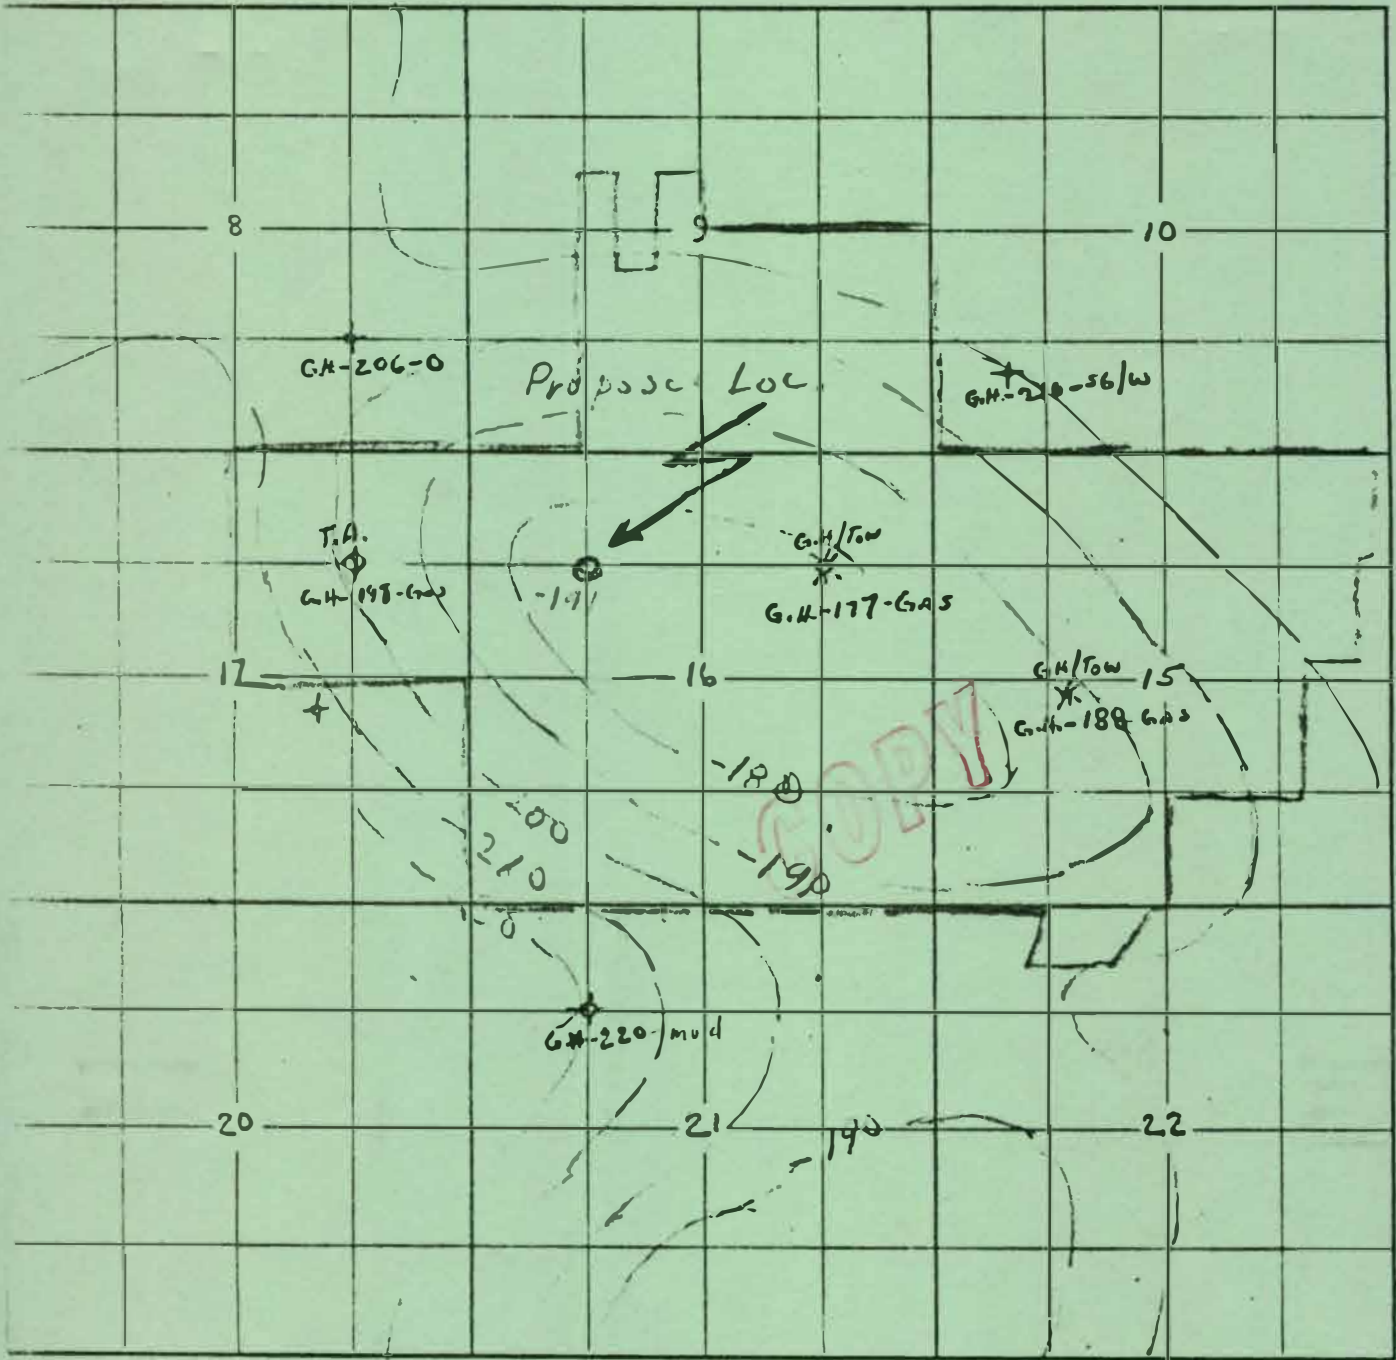

1-15-76
W.B. Clement

TOP Grand Haven Limestone
C.I. = 10'

- ✓ Lee #686 - KROBOTH #2 - C NW/4 of Sec. 16-168-7W, Ellsworth County, Kansas
- Lee #685 - KANAK #1 - 100' SE of C W/2 of Sec. 16-168-7W. "
- Lee #689 - VONDRA #1 - C NE/4 of Sec. 16-168-7W, "