



State Corporation Commission

CONSERVATION DIVISION

(Oil, Gas and Water)
245 North Water
WICHITA, KANSAS 67202

March 15, 1976

REC'D MAR 16 1976

WELL PLUGGING AUTHORITY

Well No.	2
Lease	Kroboth
Description	C NW Sec. 16-16-7W
County	Ellsworth
Total Depth	1775
Plugging Contractor	Red Tiger Drilling Co.

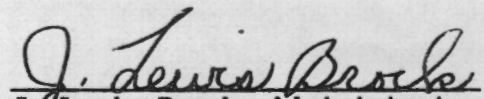
G. N. Rupe
Box 2273
Wichita, KS 67201

Gentlemen:

This is your authority to plug the above subject well in accordance with the Rules and Regulations of the State Corporation Commission.

This authority is void after 90 days from the above date.

Yours very truly,

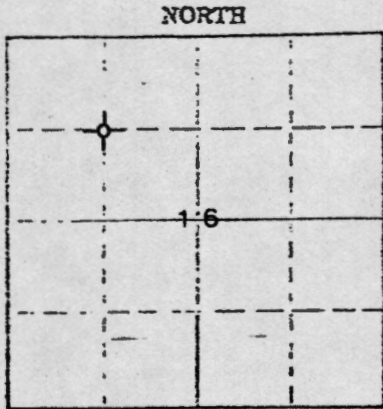

J. Lewis Brock, Administrator

Mr. Gilbert Toman, P. O. Box 180, Holyrood, KS 67450
is hereby assigned to supervise the plugging of the above
named well.

STATE OF KANSAS
STATE CORPORATION COMMISSION
CONSERVATION DIVISION
P. O. BOX 17027
WICHITA, KANSAS 67217

WELL PLUGGING RECORD

Ellsworth County, Sec 16 Twp 16S Rge 7 ~~828~~ (W)
Location as "NE/CNW/SE/SW" or footage from lines C/NW 1/4
Lease Owner Rupe Oil Co.
Lease Name Kroboth Well No 2
Office Address 200 W. Douglas, Suite 925, Wichita, Ks. 67202
Character of Well (completed as Oil, Gas or Dry Hole) dry hole
Date well completed March 3, 1976 19
Application for plugging filed March 2, 1976 19
Application for plugging approved March 2, 1976 19
Plugging commenced March 3, 1976 19
Plugging completed March 3, 1976 19
Reason for abandonment of well or producing formation D&A



Locate well correctly on above Section Plat

If a producing well is abandoned, date of last production 19
Was permission obtained from the Conservation Division or its agents before plugging was commenced? yes

Name of Conservation Agent who supervised plugging of this well Gilbert Toman
Producing formation _____ Depth to top _____ Bottom _____ Total Depth of Well 1775 Feet
State depth and thickness of all water, oil and gas formations.

OIL, GAS OR WATER RECORDS

CASING RECORD

FORMATION	CONTENT	FROM	TO	SIZE	PUT IN	PULLED OUT
				8 5/8"	217'	-0-

Describe in detail the manner in which the well was plugged, indicating where the mud fluid was placed and the method or methods used in introducing it into the hole. If cement or other plugs were used, state the character of same and depth placed, from _____ feet to _____ feet for each plug set.

Plug @ 210' w/25 sx cmt
Plug @ 40' w/10 sx cmt + 1/2 sx hulls
2 sx cmt in rathole

(If additional description is necessary, use BACK of this sheet)

Name of Plugging Contractor Red Tiger Drilling Co.
Address 1720 KSB&T Bldg, Wichita, Ks. 67202

STATE OF Kansas COUNTY OF Sedgwick, ss.
Jean Stocks (employee of owner) or (owner or operator) of the above-described well, being first duly sworn on oath, says: That I have knowledge of the facts, statements, and matters herein contained and the log of the above-described well as filed and that the same are true and correct. So help me God.

(Signature) Jean Stocks
1720 KSB&T Bldg., Wichita, Kansas 67202
(Address)

Subscribed and sworn to before me this _____ day of _____, 19____

My commission expires _____
D'Ann Drennan Notary Public



*mailed original
3/15/76
State Arch.*