
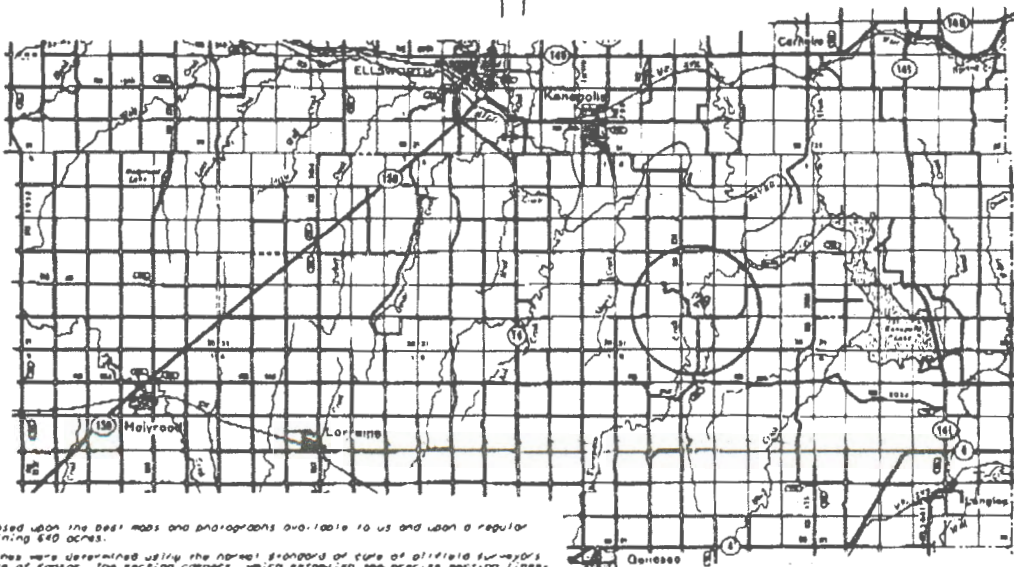


HUDSON (BETTENBROCK) PROSPECT

- [illegible]

RUPE OIL COMPANY, INC.
HUDSON LEASE
NW 1/4, SECTION 28, T16S, R7W
ELLSWORTH COUNTY, KANSAS

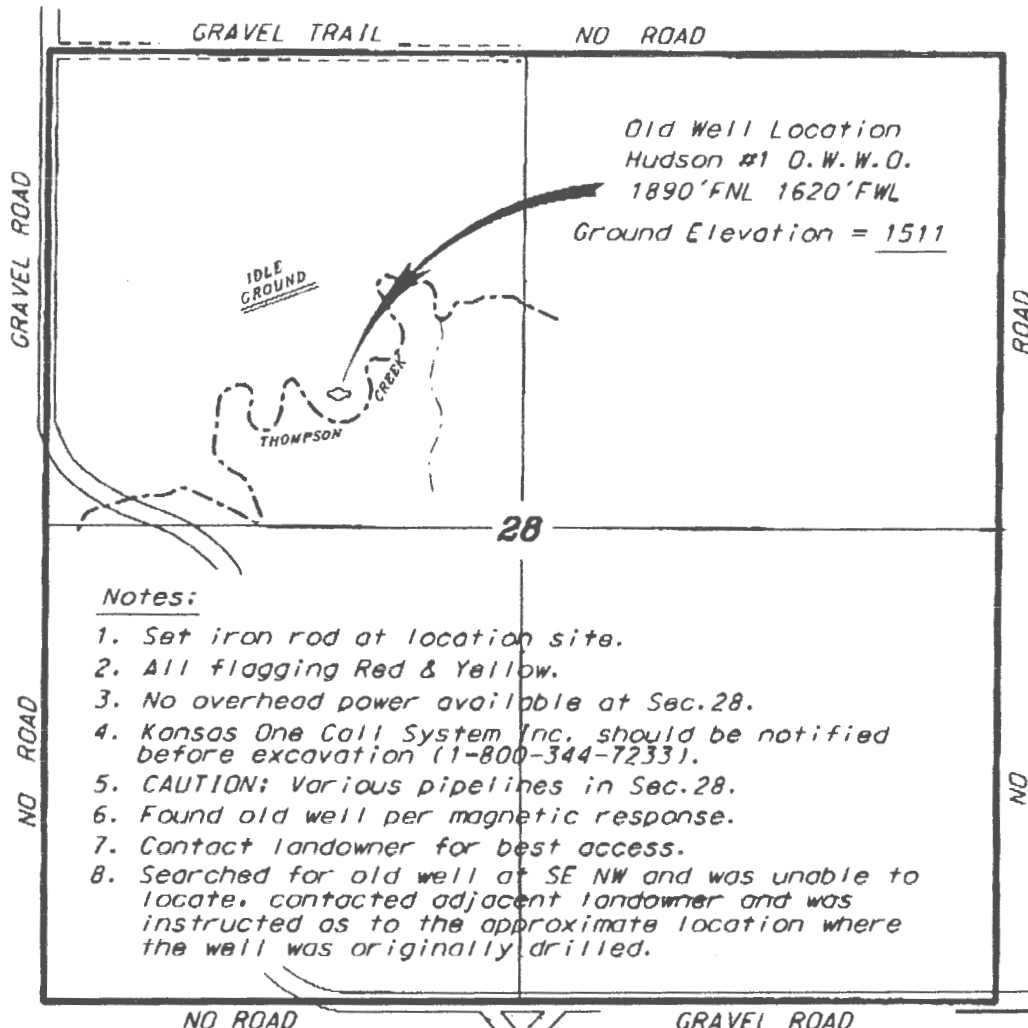

* Controlling data is based upon the best maps and photographs available to us and upon a regular section of land containing 640 acres.

* Approximate section lines were determined using the normal standards of type of oilfield surveys practicing in the state of Kansas. The section corners, which establish the precise section lines, were not necessarily located, and the exact location of the drill site location in the section is not guaranteed. Therefore, the operator assuming this service and accepting this plot and all other parties relying thereon agree to hold Central Kansas Oilfield Services, Inc., its officers and employees harmless from all losses, costs and expenses and hold entities released from any liability from incidental or consequential damages.

* Elevations derived from National Geodetic Vertical Datum.

Date August 4, 2006

CENTRAL KANSAS OILFIELD SERVICES, INC. (620)792-1977

ELLSWORTH COUNTY, KANSAS

HUDSON (BETTENBROCK) PROSPECT

FEDERAL LEASE B-233 NW/4 31.9 ACRES SEC. 28-16S-7W

B-234 NE/4 80.3 ACRES

B-236 NE/4 32.48 ACRES

144.68 ACRES expires 10/1/83

drapped 4/25/86

~~PEARLY OLIVER E. RINGER SE 1/4 1/2 NE 1/4 SEC. 29 16S 7W AND SW 1/4 1/2 NE 1/4 SEC. 28-16S-7W 400 ACRES OCTOBER 3, 1988.~~

think set go 10/1/84 need 4/25/86



