


WELL PLUGGING RECORD

Information Completely
Required Amdt-It
all or Deliver Report to:
Conservation Division
State Corporation Commission
211 No. Broadway
Wichita, Kansas

NORTH

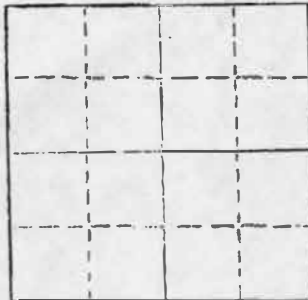

Locate well correctly on above
Section Plot

Ellsworth County, Sec 28 Twp 16S Rge. (E) 7 (W)
Location as "NE/CNW/SW" or footage from lines 660' E line; 660' S line of N
Lease Owner Producers Pipe Line Company, Inc.
Lease Name Hudson Well No. 1
Office Address Box 1417, Topeka, Kansas
Character of Well (completed as Oil, Gas or Dry Hole) Dry Hole
Date well completed 9/24 1957
Application for plugging filed 9/24 1957
Application for plugging approved 9/24 1957
Plugging commenced 9/24 1957
Plugging completed 9/24 1957
Reason for abandonment of well or producing formation Dry Hole

If a producing well is abandoned, date of last production 19
Was permission obtained from the Conservation Division or its agents before plugging was com-
menced? Yes

Name of Conservation Agent who supervised plugging of this well Ruel Durken
Producing formation Depth to top Boltout Total Depth of Well 2992 Feet
Show depth and thickness of all water, oil and gas formations.

OIL, GAS OR WATER RECORDS

CASING RECORD

FORMATION	CONTENT	FROM	TO	SIZE	PUT IN	PULLED OUT
				8-5/8"	221	None

Describe in detail the manner in which the well was plugged, indicating where the mud fluid was placed and the method or methods used in introducing it into the hole. If cement or other plugs were used, state the character of same and depth placed, from feet to feet for each plug set.

Put good plug @ 230' with 15 sacks cement
Another good plug and 5 sacks cement on top.

(If additional description is necessary, use BACK of this record)

Name of Plugging Contractor Greenland Drilling Company
Address 1722 Broadway, Kansas City, 12, Mo.

STATE OF KANSAS COUNTY OF Sedgewick ss.

Oscar Bridge (employee of owner) or (owner or operator) of the above-described well, being first duly sworn on oath, says: That I have knowledge of the facts, statements, and matters herein contained and the log of the above-described well as filed and that the same are true and correct. So help me God.

(Signature)

Oscar Bridge, Vice-President, Greenland Drilling
1722 Broadway, Kansas City, Mo.

(Address)

Subscribed and sworn to before me this 30th day of September, 1957

Verdine B. Rutledge

My commission expires March 15, 1960

Notary Public.

PLUGGING

FILE SEC 28 T 16 R 74
BOOK PAGE 47 LINE 34

STATE OF KANSAS
STATE CORPORATION COMMISSION


Give All Information Completely
Make Required Affidavit
Mail or Deliver Report to:
Conservation Division
State Corporation Commission
212 No. Market
Wichita, Kansas 67202

WELL PLUGGING RECORD

File
Hudson
1-28
CP-4

Ellsworth County, Sec. 28 Twp. 16 Rge. 7 (E) (W) X
Location as "NE/CN/SE/SW" or footage from lines. C/SE/NW

Lease Owner Circle Oil Company
Lease Name Pearl F. Hudson Well No. 1
Office Address 500 Bitting Bldg. Wichita, Kansas
Character of Well (completed as Oil, Gas or Dry Hole)
Date well completed 19
Application for plugging filed 19
Application for plugging approved 19
Plugging commenced 3-2-72 19
Plugging completed 3-3-72 19
Reason for abandonment of well or producing formation Depleted

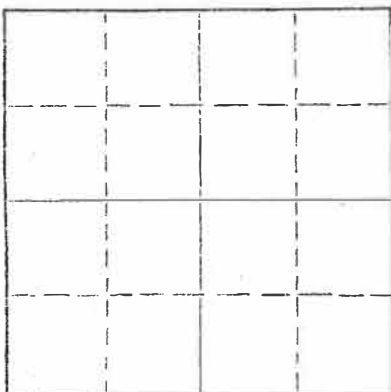

Locate well correctly on above
Section Plat

Name of Conservation Agent who supervised plugging of this well Gilbert Toman
Producing formation Depth to top Bottom Total Depth of Well 3010 Feet
Show depth and thickness of all water, oil and gas formations.

OIL, GAS OR WATER RECORDS

CASING RECORD

FORMATION	CONTENT	FROM	TO	SIZE	PUT IN	PULLED OUT
				8 5/8	210	None
				5 1/2	2982	1624.52'

Describe in detail the manner in which the well was plugged, indicating where the mud fluid was placed and the method or methods used in introducing it into the hole. If cement or other plugs were used, state the character of same and depth placed, from feet to feet for each plug set.

Pushed a plug to 2400'. Sanded to 2370' and dumped 5 sacks cement. Shot casing at 1731 and 1618 ft. Laid down a total of 52 joints of 5 1/2" casing. Built a rock bridge from 210 to 200', and dumped 30 sacks cement. Filled hole with mud to 40' and built a 10' rock bridge. Capped well with 10 sacks cement.

RECEIVED
STATE CORPORATION COMMISSION
MAR 13 1972
CONSERVATION DIVISION
Wichita, Kansas

Name of Plugging Contractor Rockhold Engineering, Inc.
Address Box 698 Great Bend, Kansas 67530

STATE OF Kansas COUNTY OF Barton, SS.
James W. Rockhold (employee of owner) or (owner or operator) of the above-described

well, being first duly sworn on oath, says: That I have knowledge of the facts, statements, and matters herein contained and the log of the above-described well as filed and that the same are true and correct. So help me God.

(Signature) James W. Rockhold James W. Rockhold
Box 698 Great Bend, Kansas 67530

(Address)

CATHY MILLER
NOTARY PUBLIC
Barton County, Ks.

SUBSCRIBED AND SWORN TO before me this 8th day of March, 1972

Cathy Miller
Cathy Miller Notary Public.

My commission expires September 30, 1975