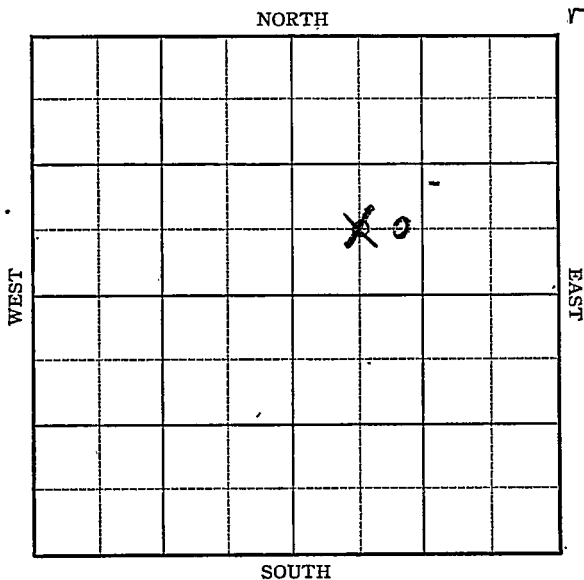


FORM 51 5M 1-42 PETROL

Section 7 Township 16 Range 10-W

Well No. #1 Harbacek

Company Nate Appleman

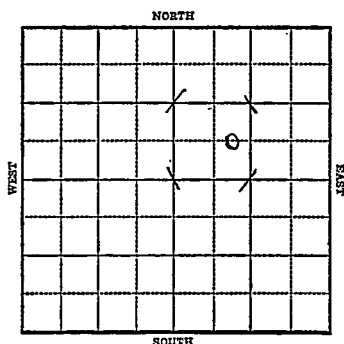


KANSAS

Ellsworth

Sec. 7 Twp. 16 R. 10-WWell No. #1 Harbacek FarmNate Appleman Company

Stoltenberg

 Ft. from N. Line660 Ft. from S. Line Ft. from E. Line990 Ft. from W. LineElev. 1831

1943

R E P O R T

3/24	Location	Lario Farmout
3/31	" "	
4/7	Surface hole	
4/14	8" @ 378	
	Anhy 645	
	Drlg. 2035'	
4/21	Topeka 2645	
	Lans 3000	
	Drlg. 3148'	
4/28	Arb 3299	
	T.D. 3301	
	5" @ 3300' RUST.	
5/5	T.D. 3322-500 acid 1 oil per hr.	
5/12	Swab 12 fluid per hr 50% water	
	12 hrs.	
5/19	" "	
5/26	Arb. 3299	
	5" @ 3300'	
	T.D. 3322'	
	Pump 123 oil plus 58% water Pot.	
	Gravity 44	

COMPLETED

Ellsworth

KANSAS

Map No. 55 Sec. 7 Twp. 16 R. 10WWell No. 1 Harbacek

Nate Appleman

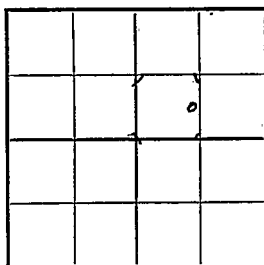
Company

FIRST REPORT

Contractor

C E L S W N E

SECTION PLAT

 Ft. from N. Line660 Ft. from S. Line Ft. from E. Line990 Ft. from W. Line

STOLTENBERG POOL

Location XXXRig up

Drilling and Remarks:

Lario Farmout

RECORD

Cased in., ft.Sand Gas Oil Total Depth

PRODUCTION

1st 24 hrs. Nat. 1st 24 hrs. after shot Gas Cu. Ft.Dry Hole Abandoned

Date

MAR 24 1943

19

S. J. LEWIS

Scout

Ellsworth

KANSASMap No. 55 Sec. 7 Twp. 16 R. 10 WWell No. 1 HarbacekNate Appleman

Company

COMPLETED

Contractor

C E L S W N E

SECTION PLAT

 Ft. from N. Line660 Ft. from S. Line Ft. from E. Line99'0 Ft. from W. Line

STOLTENBERG POOL

Location Rig up

Drilling and Remarks:

*Core 3299**5" @ 3300**Pump 123 oil +**58% Water Pot**440 Gr*

RECORD

Cased in., ft.Sand Gas Oil Total Depth 3322

PRODUCTION

1st 24 hrs. Nat. 1st 24 hrs. after shot Gas Cu. Ft.Dry Hole Abandoned

Date

MAY 26 1943

19

S. J. LEWIS

Scout