


Ellsworth

Form 51-5M-5-34-Palace

Map No. **KANSAS** Sec. 7 Twp. 16 R. 10^W

Well No. 1 Harbarch Farm
Lario Oil & Gas Company

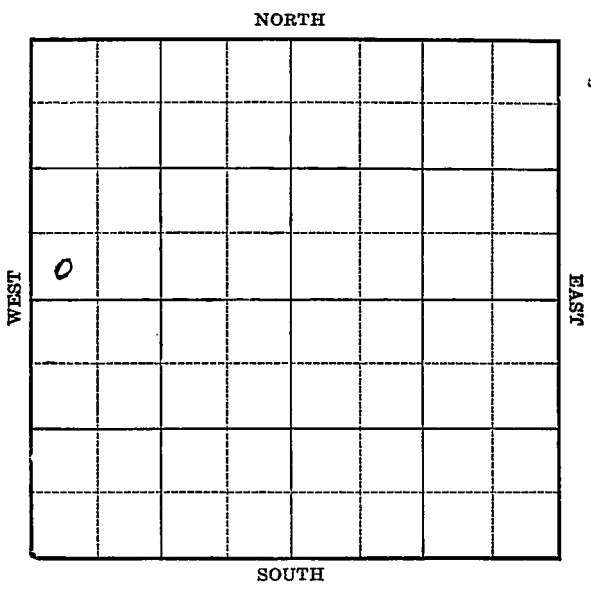

Location _____
Drilling Remarks _____

Rig Up _____
Drilling Remarks _____

RECORD

Cased _____ in. _____ ft.
Sand _____
Gas _____
Oil _____
Total Depth _____

PRODUCTION

1st 24 hrs. Nat. _____
1st 24 hrs. after shot _____
Gas _____ cu. ft. _____
Dry Hole _____
Abandoned _____

Ellsworth

Map No. KANSAS Sec. 7 Twp. 16 R. 10^W
Well No. 1 Harbarch Farm
Lario Oil & Gas Company

 Ft. from N. Line

330 Ft. from S. Line

 Ft. from E. Line

330 Ft. from W. Line

NORTH									
SOUTH									

REPORT

Date	Location
9/5	Location
9/13	Rig
9/20	350' Run 15"
9/27	Dlg 925
10/4	10" 1578 C.O.
10/11	—
10/18	2315 log
10/25	—
11/4	Dlg 2400
11/8	" 2975 8" 2404
11/15	" 3310 6" 3035
11/21	Silicious 3370 T 1 3394
	HFW 7r A

ABANDONED

KANSAS

Map No. 55 Sec. 7 Twp. 16 R. 10WWell No. #1 - HarbarickLario oil & Gas Company

Contractor

SECTION PLAT

FIRST REPORTS

 Ft. from N. Line330 Ft. from S. Line Ft. from E. Line330 Ft. from W. Line

0			

Location ✓
PPRig up

Drilling and Remarks:

RECORD

Cased in., ft.Sand Gas Oil Total Depth

PRODUCTION

1st 24 hrs. Nat. 1st 24 hrs. after shot Gas Cu. Ft.Dry Hole Abandoned

Date

9-5-31 19

ORVAL MANNSCHRECK

Scout

KANSAS

Map No. 55 Sec. 7 Twp. 16 R. 10WWell No. 1-HarbackLouis oil

Company

Contractor

ABANDONED

SECTION PLAT

0			

 Ft. from N. Line330 Ft. from S. Line Ft. from E. Line330 Ft. from W. LineLocation Rig up

Drilling and Remarks:

H. F. W.NO + F

RECORD

Cased in., ft.Sand 3370Gas Oil Total Depth 3394

PRODUCTION

1st 24 hrs. Nat. 1st 24 hrs. after shot Gas Cu. Ft.Dry Hole Abandoned

Date

11-21-34 19

ORVAL MANNSCHRECK

Scout