

KANSAS


FORM 51 5M 4-41 PETROL

Ellsworth

Section 7 Township 16 Range 10-W

Well No. 1 Jezek

Company Herndon Drilling

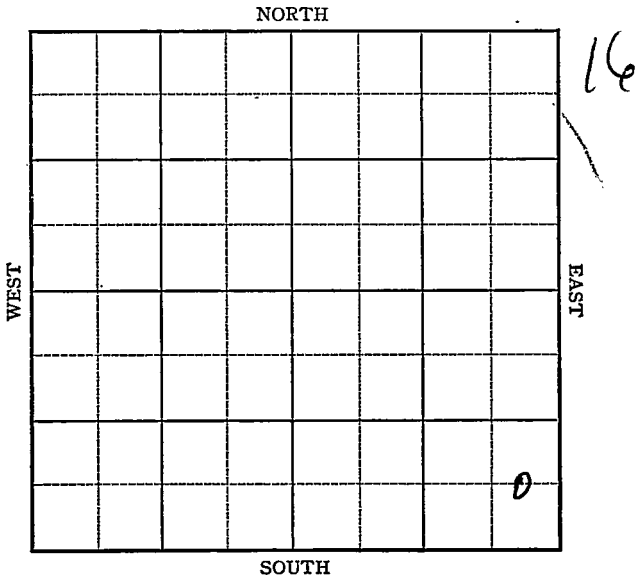

Sec. 7 Twp. 16 R. 10-W

Well No. #1 Jezek Farm

Hemdon Drilling Company

(Stoltenberg)


_____ Ft. from N. Line

660 Ft. from S. Line

330 Ft. from E. Line

_____ Ft. from W. Line

Elev. 1890

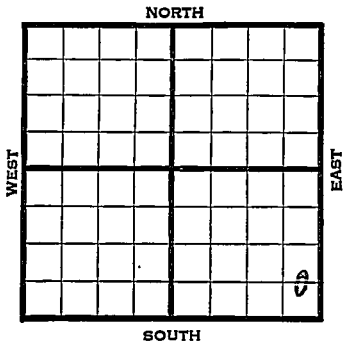

1941	REPORT
7/9	8" - 360'
	Drlg. 3175'
7/17	Lans. 3035' Arb. 3366'
	5" - 3367' Drlg. 3375'
7/24	TD 3375 swab 25 oil a day.
7/31	500 acid swab 100 oil 30 water in 12 hrs.
8/6	Arb 3366'
	5" @ 3367'
	TD 3375'
	500 acid.
	Pump 232 Oil & 30% water
	Potential
	Gravity 44.
	COMPLETED

Map No. _____ Sec. 7 Twp. 16 R. 10WWell No. 1 JezekHerndon Drilling Company

Contractor

FIRST REPORT

C E L S E S E

SECTION PLAT

_____ Ft. from N. Line

660 Ft. from S. Line330 Ft. from E. Line

_____ Ft. from W. Line

STOLTENBERG POOL

Location _____

Rig up _____

Drilling and Remarks:

8" - 360Drlg. 3175

RECORD

Cased _____ in., _____ ft.

Sand _____

Gas _____

Oil _____

Total Depth _____

PRODUCTION

1st 24 hrs. Nat. _____

1st 24 hrs. after shot _____

Gas _____ Cu. Ft.

Dry Hole _____

Abandoned _____

Date

JUL 9 1941

19

S. J. LEWIS Scout

Ellsworth

Form 26—200 Bks.—1-40—Palace

~~ELLSWORTH~~

KANSAS

Map No. _____ Sec. 7- Twp. 16 R. 10W

Well No. 1 Jezek

Herndon Drilling Company

Contractor

COMPLETED

SECTION PLAT

C E L S E S E

_____ Ft. from N. Line

660 Ft. from S. Line

330 Ft. from E. Line

_____ Ft. from W. Line

STOLTENBERG POOL

Location _____

RECORD

Cased _____ in., _____ ft.

Sand _____

Gas _____

Oil _____

Total Depth 3325

Rig up _____

Drilling and Remarks:

Cr #3366

5" @ 3367

500 Acid

Pump. 232 out

+ 30% Water Prod.

440 Gr.

PRODUCTION

1st 24 hrs. Nat. _____

1st 24 hrs. after shot _____

Gas _____ Cu. Ft.

Dry Hole _____

Abandoned _____

Date

AUG 6 1941

S. J. LEWIS Scout