

KANSAS

Section 7 Township 16 Range 10W

Well No. 1 Harbeck

Company B & R Drlg.

Stoltenberg

NORTH

WEST

EAST

SOUTH

							o

8

Sec. 7 Twp. 16 R. 10W ✓

Well No. #1 Harbeck Farm

B & R Drlg. Company

Stolten- (B & R Drlg., Cont.)
berg


NORTH

_____ Ft. from N. Line

250' Ft. from S. Line

250' Ft. from E. Line

_____ Ft. from W. Line

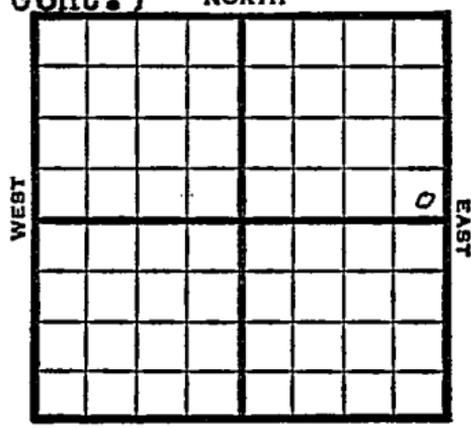

SE NE

SOUTH

1949 Elev 1879' REPORT

8/10 RUR
 8/17 8" @ 341'
 Drlg 2085(

 8/24 Lansing 3039
 Arbuckle 3341-44
 TD 5" @ 3343'.

 8/31 TD 3356'
 Arb. 3341'
 5 @ 3343'
 500 acid
 Pump 60 oil Pot
 42° Gr.
 Comp

COMPLETED

Map No. _____ Sec. 7 Twp. 16 R. 10W

Well No. 1 Harbeck

B & R Drlg. Company

B & R Drlg. Contractor

SE NE

FIRST REPORT
SECTION PLAT

_____ Ft. from N. Line

250 Ft. from S. Line

250 Ft. from E. Line

_____ Ft. from W. Line

			o

Ellsworth County

Location _____

Rig up _____

Drilling and Remarks:

R U R

RECORD

Cased _____ in., _____ ft.

Sand _____

Gas _____

Oil _____

Total Depth _____

PRODUCTION

1st 24 hrs. Nat. _____

1st 24 hrs. after shot _____

Gas _____ Cu. Ft.

Dry Hole _____

Abandoned _____

Date

AUG 10 1949 19

S. J. LEWIS Scout

Kansas

Stoltenberg Pool

Map No. K55 Sec. 7 Twp. 16 R. 10WWell No. 1 HarbeckB & R Drlg.

Company

COMPLETE

Contractor

SE NE

E11877
SECTION PLAT

_____ Ft. from N. Line

250 Ft. from S. Line250 Ft. from E. Line

_____ Ft. from W. Line

			o

Ellsworth County

RECORD

Location _____

Cased _____ in., _____ ft.

Rig up _____

Sand _____

Drilling and Remarks:

Gas _____

Oil _____

Total Depth 3356**PRODUCTION**

1st 24 hrs. Nat. _____

1st 24 hrs. after shot _____

Gas _____ Cu. Ft.

Dry Hole _____

Abandoned _____

Date

AUG 31 1949

19

S. J. LEWIS

Scout

Core 3341
5" @ 3343
500 acid
Prod 60 oil Pt.
42° Su