


Section 7 Township 16 Range 10W

Well No. #1, Harbacek

Company Black-Marshall

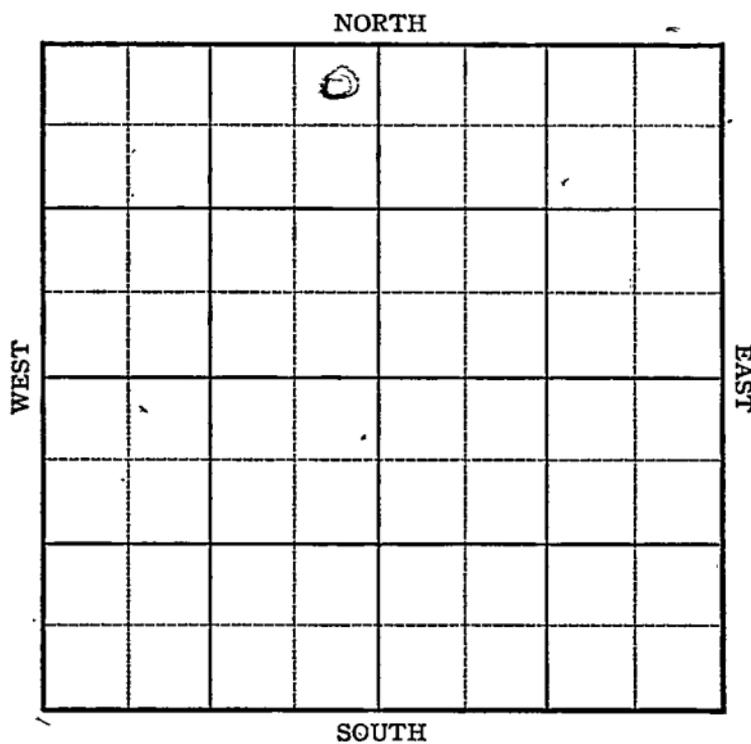

Sec. 7 Twp. 16 R. 10W

Well No. #1 Herbacek Farm

Black-Marshall Company

Stoltenberg


330 Ft. from N. Line

\_\_\_\_\_ Ft. from S. Line

330 Ft. from E. Line

\_\_\_\_\_ Ft. from W. Line

NE NW

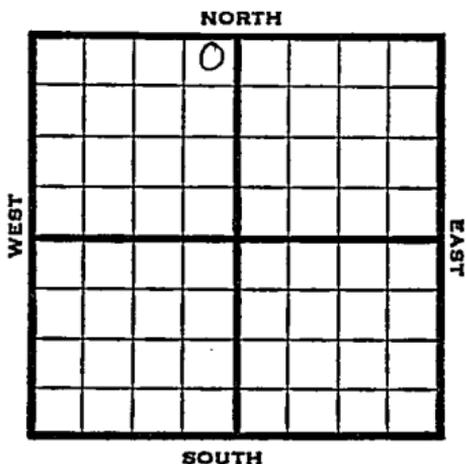

1946 Elev 1830' REPORT

4/17 8" @ 356' WOC

4/23 Anhy 635  
Drlg 3000

5/1 Lans 2988  
Arb 3297-98  
TD 5" @ 3298 RUST

5/7 TD 3315-500 acid  
swb 2 oil PH 6 hrs.

5/14 1000 acid  
Swb 16 oil PH 9 hrs

5/21 " " "

5/29 Arb 3297  
5" @ 3298'  
TD 3315  
1500 acid  
Depth pot 962  
42.0 Gr.

COMPLETED

**KANSAS**  
33

Kansas Pool Name Stoltenberg

Map No. \_\_\_\_\_ Sec. 7 Twp. 16 R. 10W

Well No. 1 Harbacek

Black-Marshall Company

**FIRST REPORT** Contractor

NE NW


**SECTION PLAT**

330 Ft. from N. Line

\_\_\_\_\_ Ft. from S. Line

330 Ft. from E. Line

\_\_\_\_\_ Ft. from W. Line

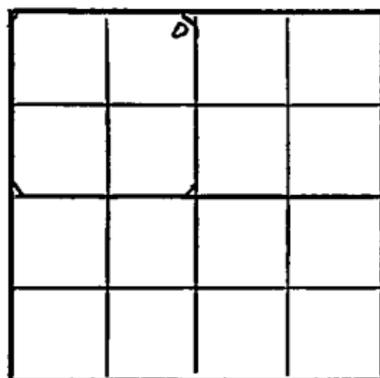

Ellsworth, County

Location \_\_\_\_\_

Rig up \_\_\_\_\_

Drilling and Remarks:

8" @ 356 WOC

**RECORD**

Cased \_\_\_\_\_ in., \_\_\_\_\_ ft.

Sand \_\_\_\_\_

Gas \_\_\_\_\_

Oil \_\_\_\_\_

Total Depth \_\_\_\_\_

**PRODUCTION**

1st 24 hrs. Nat. \_\_\_\_\_

1st 24 hrs. after shot \_\_\_\_\_

Gas \_\_\_\_\_ Cu. Ft.

Dry Hole \_\_\_\_\_

Abandoned \_\_\_\_\_

Date \_\_\_\_\_

APR 17 1946 19

S. J. LEWIS Scout

KANSAS Pool Name Stoltenberg  
 Pool  
 Map No. 55 Sec. 7 Twp. 16 R. 10W  
 Well No. 1 Harbacek

Black-Marshall Company

**COMPLETED**

Contractor

NE NW

E11830

SECTION PLAT

330 Ft. from N. Line

\_\_\_\_\_ Ft. from S. Line

330 Ft. from E. Line

\_\_\_\_\_ Ft. from W. Line

	0		

Ellsworth County

Location \_\_\_\_\_

Rig up \_\_\_\_\_

Drilling and Remarks:

Cor Y3297

5" @ 3298.

15000 cu ft

Depth 962

42° SW

**RECORD**

Cased \_\_\_\_\_ in., \_\_\_\_\_ ft.

Sand \_\_\_\_\_

Gas \_\_\_\_\_

Oil \_\_\_\_\_

Total Depth 962

**PRODUCTION**

1st 24 hrs. Nat. \_\_\_\_\_

1st 24 hrs. after shot \_\_\_\_\_

Gas \_\_\_\_\_ Cu. Ft.

Dry Hole \_\_\_\_\_

Abandoned \_\_\_\_\_

Date

MAY 29 1946 19 \_\_\_\_\_

S. J. LEWIS Scout