

KANSAS


Form 51-5M-7-39-Palace

Ellsworth

Section 7 Township 16 Range 10-W

Well No. #1 Harbacek

Company Skelly

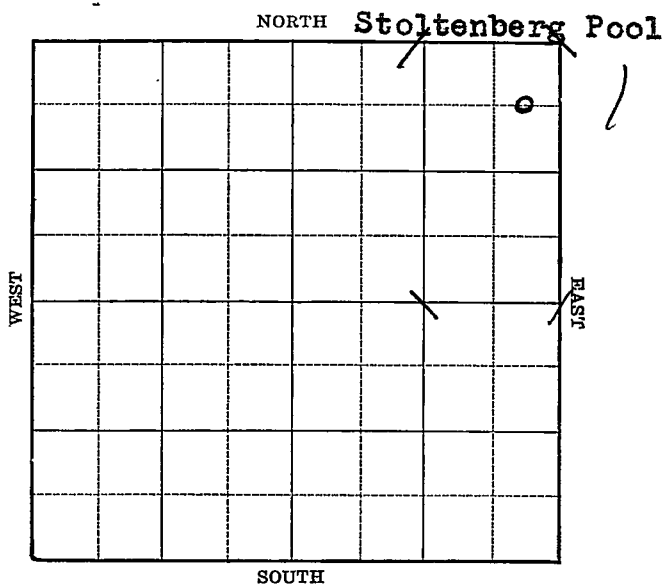

KANSAS

Ellsworth

Sec. 7 Twp. 16 R. 10-WWell No. #1 Harbacek Farm

Skelly

Company

(Stoltenberg)


660 Ft. from N. Line

Ft. from S. Line

330 Ft. from E. Line

Ft. from W. Line

Elev. 1835

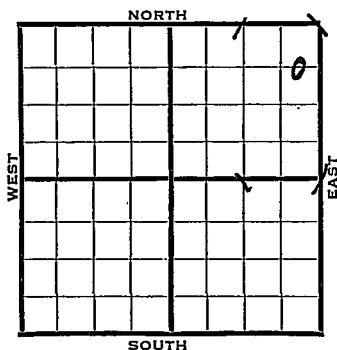

1940	REPORT
6/12	Rotary.
6/20	8" - 375' Drlg. 400'
6/27	Drlg. 240.8'
7/3	Arb. 3311' ^{3311'} T.D. 3316'
	4" - 3311' ^{3311'} RUST.
7/11	Arb. 3311' (Corrected)
	4" - 3311' T.D. 3319½'
	200' oil 8 hours.
7/18	T.D. 3325' 1500 acid.
	2800' oil.
7/24	Arb. 3311'
	4" - 3311'
	T.D. 3325'
	2250 acid.
	Echometer potential 426 bbls.
	COMPLETED

Map No. 55 Sec. 7 Twp. 16 R. 10WWell No. 1 HarbacekSkelly Company

Contractor


FIRST REPORT

C E L N E N E

660 Ft. from N. Line Ft. from S. Line330 Ft. from E. Line Ft. from W. Line

STOLTENBERG POOL

SECTION PLAT

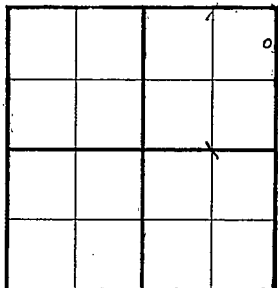Location Rig up

Drilling and Remarks:

Rotary

RECORD

Cased in., ft.Sand Gas Oil Total Depth

PRODUCTION

1st 24 hrs. Nat. 1st 24 hrs. after shot Gas Cu. Ft.Dry Hole Abandoned

Date

JUN 12 1940 19

S. J. LEWIS Scout

Map No. _____ Sec. 7 Twp. 16 R. 10WWell No. 1 HarbacekSkelly Oil

Company _____

Contractor _____

COMPLETED**C E L N E N E**660 Ft. from N. Line

_____ Ft. from S. Line

330 Ft. from E. Line

_____ Ft. from W. Line

STOLTENBERG POOL**SECTION PLAT**

			2

Location _____

Rig up _____

Drilling and Remarks:

*CR 83311**4" @ 3311**2250 acid**Echo meter P.D.**426***RECORD**

Cased _____ in., _____ ft.

Sand _____

Gas _____

Oil _____

Total Depth. *3325***PRODUCTION**

1st 24 hrs. Nat. _____

1st 24 hrs. after shot _____

Gas _____ Cu. Ft.

Dry Hole _____

Abandoned _____

Date

JUL 24 1940S. J. LEWIS Scout