

KANSAS


FORM 51 5M 11-44 PETROL

Ellsworth

Section 7 Township 16 Range 10W

Well No. #1 Harbeck

Company Larco Oil

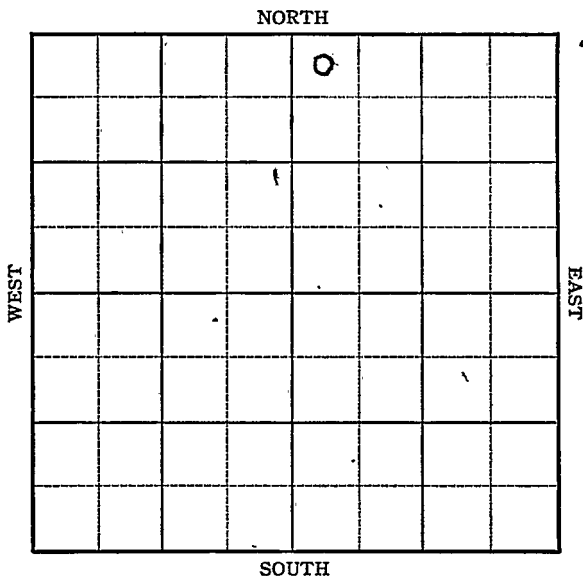

KANSAS

Ellsworth county ✓

Sec. 7 Twp. 16 R. 10W

Well No. #1, Harbeck Farm

Larco Oil Company

Stoltenberg


330 Ft. from N. Line

Ft. from S. Line

Ft. from E. Line

330 Ft. from W. Line

NW NE

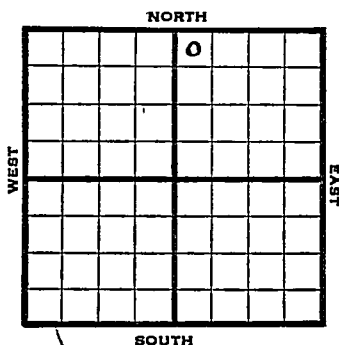

1946 Elev. 1819 REPORT


6/12 Location
6/18 8" @ 357.
Drlg 1670'
6/26 Arb 3300-02 TD
Run 5"
7/3 Lams 2984
5" @ 3300'
TD 3309'
1500 acid swb 1 1/4 oil PH 9 hrs
31 shots 3301-08
fail 42 gals oil plus 31% W PH
7/10 Arb. 3300
5" @ 3300
1000 acid.
TD 3309
Pump 20 Potl
Grav. 42.0

COMPLETED

KANSAS Kansas Pool Name StoltenbergMap No. 53 Sec. 7 Twp. 16 R. 10WWell No. 1 HarbeckLarco Oil CompanyFIRST REPORT Contractor

NW NE

SECTION PLAT

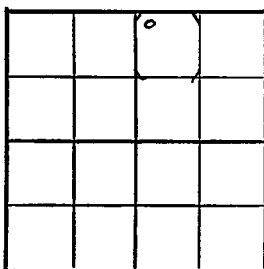330 Ft. from N. Line Ft. from S. Line Ft. from E. Line330 Ft. from W. LineEllsworth CountyLocation XRig up

Drilling and Remarks:

RECORD

Cased in, ft.Sand Gas Oil Total Depth

PRODUCTION

1st 24 hrs. Nat. 1st 24 hrs. after shot Gas Cu. Ft.Dry Hole Abandoned

Date

JUN 12 1946

19

S. J. LEWIS

Scout

KANSAS

Kansas, Pool Name Stoltenberg PoolMap No. 55 Sec. 7 Twp. 16 R. 10WWell No. 1 HarbeckLario Oil Company**COMPLETED**

Contractor

NW NE

E 1/8 19
SECTION PLAT330 Ft. from N. Line Ft. from S. Line Ft. from E. Line330 Ft. from W. Line

		0	

Ellsworth County**RECORD**Location Rig up

Drilling and Remarks:

CR 833005" @ 33001000 acidPump 20 Bbl42 2/3Cased in., ft.Sand Gas Oil Total Depth 2309**PRODUCTION**1st 24 hrs. Nat. 1st 24 hrs. after shot Gas Cu. Ft.Dry Hole Abandoned

Date

JUL 10 1946

19

S. J. LEWIS

Scout