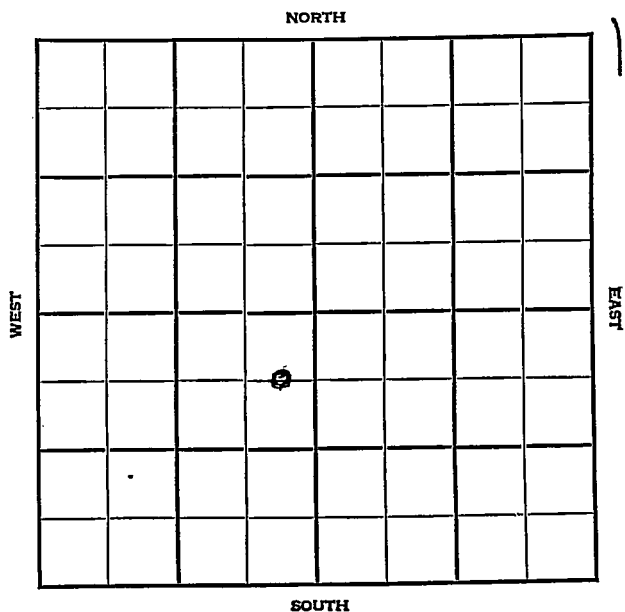


Section 7 Township 16th Range 10WWell No. #1 JazekCompany Alpine Royalty

KANSAS

Ellsworth

Sec. 7 Twp. 16 R. 10

Well No. #1 Jazek Farm

Alpine Royalty

Bloomer Pool


660' Ft. from N. Line

Ft. from S. Line

330' Ft. from E. Line

Ft. from W. Line

C E L NE SW

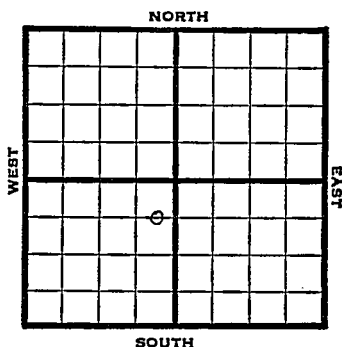

1948

Elev 1857'

R E P O R T

6/9

RUR

6/16

Lansing 3024'

Arbuckle 3341'

TD 3351'

5" @ 3346'

RUST

6/23

TD 3351'

Arb. 3341'

5"@ 3346' 500 acid

Pump 25 oil Pot

42° Gr.

Comp.

COMPLETED

Map No. _____ Sec. 7 Twp. 16 R. 10W

Well No. 1 Jazek

Alpine Royalty Company

FIRST REPORT

Contractor

C E L NE SW


SECTION PLAT

660 Ft. from N. Line

_____ Ft. from S. Line

330 Ft. from E. Line

_____ Ft. from W. Line

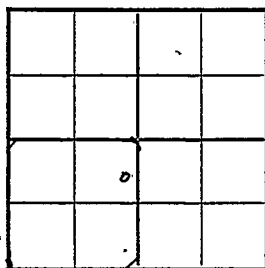

Ellsworth County

Location _____

Rig up _____

Drilling and Remarks:

R U R

RECORD

Cased _____ in., _____ ft.

Sand _____

Gas _____

Oil _____

Total Depth _____

PRODUCTION

1st 24 hrs. Nat. _____

1st 24 hrs. after shot _____

Gas _____ Cu. Ft.

Dry Hole _____

Abandoned _____

Date

JUN 9 1948 19 S. J. LEWIS Scout

Map No. 55 Sec. 7 Twp. 16 R. 10W

Well No. 1 Jazek "B"

Alpine Royalty Company

COMPLETE

Contractor

C E L NE SW

E 11837
SECTION PLAT

660 Ft. from N. Line

 Ft. from S. Line

330 Ft. from E. Line

 Ft. from W. Line

Ellsworth County

Location

Rig up

Drilling and Remarks:

Cor 3341

5" @ 3346

500 @ 3400

Prod 25 oil 100

42 2/3

RECORD

Cased in., ft.

Sand

Gas

Oil

Total Depth 3357

PRODUCTION

1st 24 hrs. Nat.

1st 24 hrs. after shot

Gas Cu. Ft.

Dry Hole

Abandoned

Date

JUN 23 1948

S. J. LEWIS Scout