

Ellsworth County


FORM 51 10M 8-47

KANSAS

Section 7 Township 16 Range 10N

Well No. #1 Jazek

Company ~~Lindas Lindas Oil~~
~~Kiesinger Oil~~

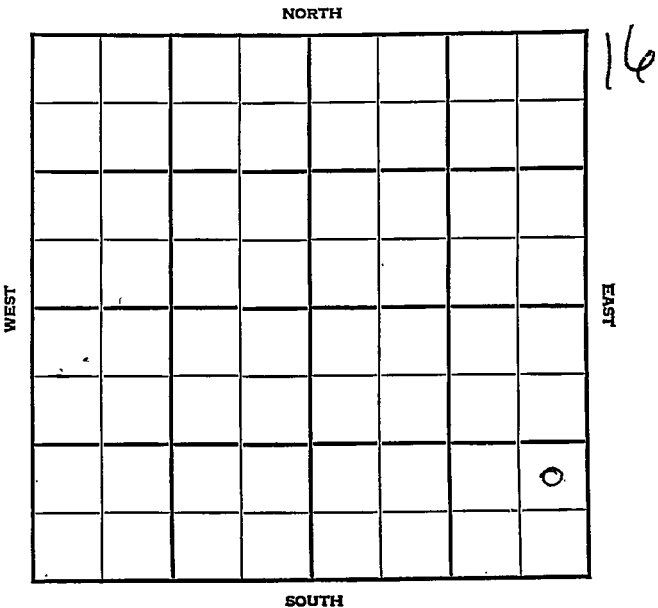

KANSAS

Ellsworth



Sec. 7 Twp. 16 R. 10-III

Well No. #1 Jazek Farm

~~Lindas~~ Lindas oil
~~Kissinger Oil~~

Company


Stoltenberg

_____ Ft. from N. Line

990' Ft. from S. Line

330' Ft. from E. Line

_____ Ft. from W. Line

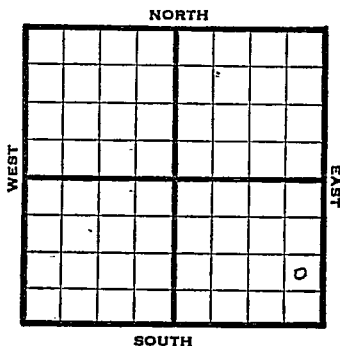

NE SE SE

1947 Elev. 1886' REPORT

12/10 Loc.

12/17 "

12/30 5" @ 3356' TD
RUST

1948

1/7 Lansing 3026'
Arbuckle 3353'
TD 3371'
3000 acid
Swb. 7 bbls. fluid PH

1/14 "

1/21 "

1/26 "

2/4 "

2/11 "

2/18 "

2/25 "

3/3 "

3/10 "

3/17 "

3/24 "

3/31 "

4/7 "

4/14 "

OVER

1948

4/21 Pump-6 bbls. W PH

4/28 Arbuckle 3353'

5" @ 3356'

Pump 25 oil & 5W Pot. .

Gr. 41°

TD 3374'

COMPLETED

Map No. _____ Sec. 7 Twp. 16 R. 10W

Well No. 1 Jazek

Kissinger Oil Company

FIRST REPORT Contractor

NE SE SE

SECTION PLAT

_____ Ft. from N. Line

990 Ft. from S. Line

330 Ft. from E. Line

_____ Ft. from W. Line

Ellsworth County

Location X

Rig up _____

Drilling and Remarks:

RECORD

Cased _____ in., _____ ft.

Sand _____

Gas _____

Oil _____

Total Depth _____

PRODUCTION

1st 24 hrs. Nat. _____

1st 24 hrs. after shot _____

Gas _____ Cu. Ft.

Dry Hole _____

Abandoned _____

Date

DEC 1 0 1947 19

S. I. LEWIS Scout

Map No. 55 Sec. 7 Twp. 16 R. 10W

Well No. 1 Jazek

Luidas Oil Company

CORRECTION Contractor

NE SE SE

SECTION PLAT

_____ Ft. from N. Line
990 Ft. from S. Line
330 Ft. from E. Line
_____ Ft. from W. Line

			o

Ellsworth County

Location _____

Rig up _____

Drilling and Remarks:

Reported as
Kissinger Oil

RECORD

Cased _____ in., _____ ft.
Sand _____
Gas _____
Oil _____
Total Depth _____

PRODUCTION

1st 24 hrs. Nat. _____
1st 24 hrs. after shot _____
Gas _____ Cu. Ft.
Dry Hole _____
Abandoned _____

Date

DEC 23 1947 19

S. J. LEWIS Scout

