

Section 7 Township 16 Range 10W

Well No. #1 Jezek (B)

Company Lindas Oil

NORTH

WEST

EAST

SOUTH

Sec. 7 Twp. 16 R. 10 W

Well No. # 1 Jezek (B) Farm

Lindas Oil Company

Lindas Contractor


 Ft. from N. Line

990 Ft. from S. Line

 Ft. from E. Line

330 Ft. from W. Line

NW SW SE

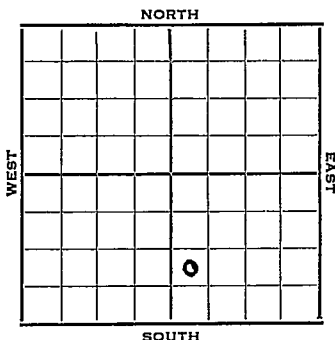

1952 Elev. 1868' REPORT

4/9 Spud 4-8-52
Drlg. 365'

4/23 8" @ 365' Anhy 660' Heeb 2923'
Br li 3024' Lans. 3037' Cong. 3346'
Arb. 3350' RTD 3355' 5" @ 3351'
WOC

4/30 NR

5/7 NR

5/14 DP DD 3362 TD 2 BOPH 500 A
No help PB 3361 POP

5/21 NR

5/28 "

6/11 P/15 BOPD

6/18 Spud 4-8-52
Oil Well TD 3362
8" @ 365 Anhy 660
Heeb. 2923 Br Lime 3024
Lans. 3037 Cong. 3346
Arb. 3350 TD 3355 5" @ 3351
DD 3362 2 boph 500 A PB 3361
Comp. 18 bopd
COMPLETED

J. G. M... ..