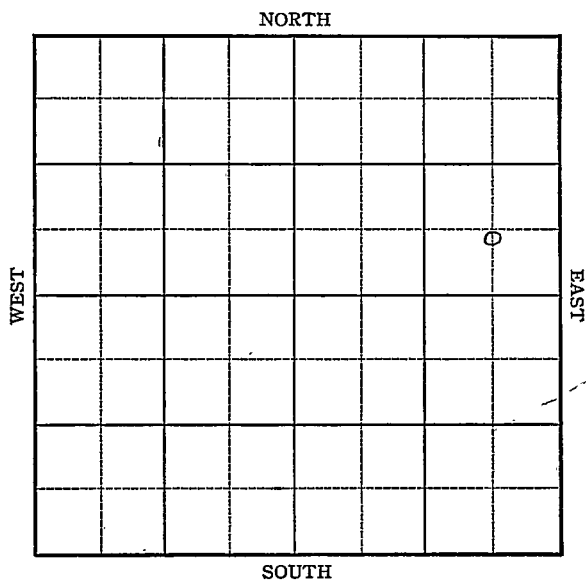


KANSAS

Ellsworth

FORM 51 5M 1-42 PETROL


Section 7 Township 16 Range 10-WWell No. #2 HarbeccekCompany Skelly

KANSAS

Ellsworth

Sec. 7 Twp. 16 R. 10-WWell No. #2 Harbacek FarmSkelly Company

Stoltenberg

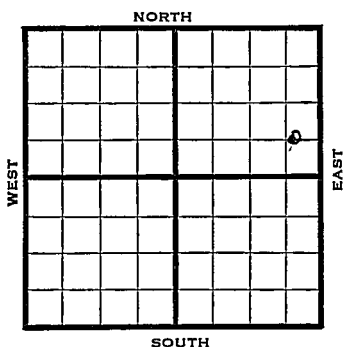 Ft. from N. Line660 Ft. from S. Line510 Ft. from E. Line Ft. from W. Line*Ells, 1882*

1943

REPORT

3/31	Location.
4/7	"
4/14	"
4/21	Rotary
4/28	10" @ 393' WOC.
5/5	1755 Fsg
5/12	Drlg. 1991'
5/19	1991 fsg
5/26	Drlg. 2100'
6/2	2319 fsg
6/9	Drlg. 2665
6/16	Drlg. 3200
6/23	Arb. 3398
	T.D. 3404'
	No shows.

ABANDONED

Ellsworth

Map No. ANSAS Sec. 7 Twp. 16 R. 10W

Well No. 2 Harbacek

Skelly Company

FIRST REPORT Contractor

C SE NE

SECTION PLAT

 Ft. from N. Line

660 Ft. from S. Line

510 Ft. from E. Line

 Ft. from W. Line

			o

STOLTENBERG POOL

Location XXX

Rig up

Drilling and Remarks:

RECORD

Cased in., ft.

Sand

Gas

Oil

Total Depth

PRODUCTION

1st 24 hrs. Nat.

1st 24 hrs. after shot

Gas Cu. Ft.

Dry Hole

Abandoned

Date

MAR 31 1943 19 S. J. LEWIS Scout

KANSAS
 Map No. 95 Sec. 7 Twp. 16 R. 10W

Well No. 2 Harbacek

Skelly

Company

ABANDONED

Contractor

C SE NE

SECTION PLAT

			o

_____ Ft. from N. Line

660 Ft. from S. Line

510 Ft. from E. Line

_____ Ft. from W. Line

STOLTENBERG POOL

Location _____

Rig up _____

Drilling and Remarks:

Cor 83393.

No house

RECORD

Cased _____ in., _____ ft.

Sand _____

Gas _____

Oil _____

Total Depth 3404

PRODUCTION

1st 24 hrs. Nat. _____

1st 24 hrs. after shot _____

Gas _____ Cu. Ft.

Dry Hole _____

Abandoned _____

Date

JUN 23 1943 19

S. J. LEWIS Scout.