

KANSAS


FORM 51 IOM 12-46 PETROL

Ellsworth

Section 7 Township 16 Range 10-W

Well No. #3 Harbacek

Company Black-Marshall

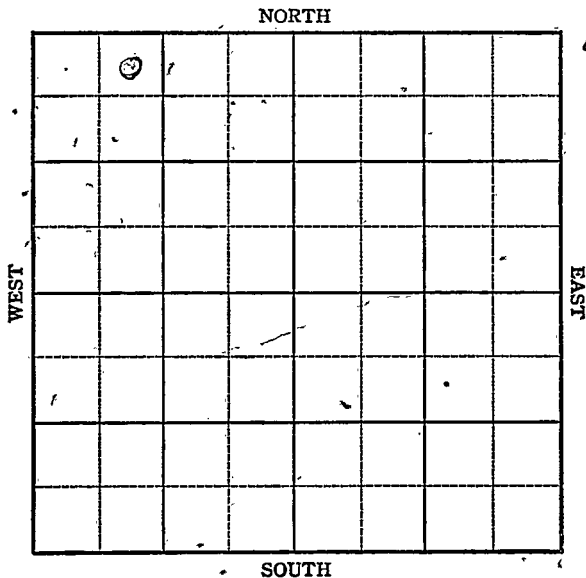

KANSAS Stoltenberg

Sec. 7 Twp. 16 R. 10-W

Well No. 3 Harbacek Farm


Black Marshall Company

NE NW NW
330 Ft. from N. Line

 Ft. from S. Line

 Ft. from E. Line

990 - Ft. from W. Line

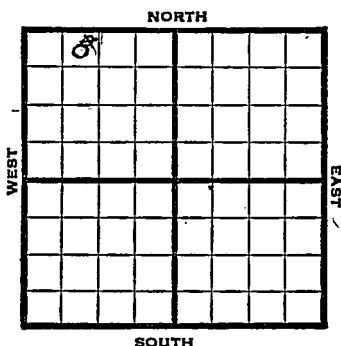

Ellsworth County

1947 1857 REPORT

2-12 Location

2/19 8" @ 358
Drlg 750'

2/26 Drlg 3058'

3/4 TD 3058'

3/12 Simp 3357
Lans 3024'
TD 3365'

3024	3357
1857	1857
1167	1500

ABANDONED

Kansas

Map No. 55 Sec. 7 Twp. 16 R. 10WWell No. 3 HarbageBlack-Marshall

Company

FIRST REPORT

Contractor

NE NW NW

SECTION PLAT

. 330 Ft. from N. Line Ft. from S. Line Ft. from E. Line990 Ft. from W. Line

15			

Ellsworth County

Location XRig up

Drilling and Remarks:

RECORD

Cased in., ft.Sand Gas Oil Total Depth

PRODUCTION

1st 24 hrs. Nat. 1st 24 hrs. after shot Gas Cu. Ft.Dry Hole Abandoned

Date

FEB 12 1947 19 S. J. LEWIS Scout

Kansas

Map No. 55 Sec. 7 Twp. 16 R. 10WWell No. 3 HarbacekBlack-Marshall

Company

ABANDONED

Contractor

NE NW NW

E1, 1857

SECTION PLAT

330 Ft. from N. Line Ft. from S. Line Ft. from E. Line990 Ft. from W. Line

0			

Ellsworth County

Location

Rig up

Drilling and Remarks:

Surf 2357
Line 3024

RECORD

Cased in., ft.

Sand

Gas

Oil

Total Depth 3365

PRODUCTION

1st 24 hrs. Nat. 1st 24 hrs. after shot Gas Cu. Ft.Dry Hole Abandoned

Date

MAR 12 1947 19S. J. LEWIS Scout