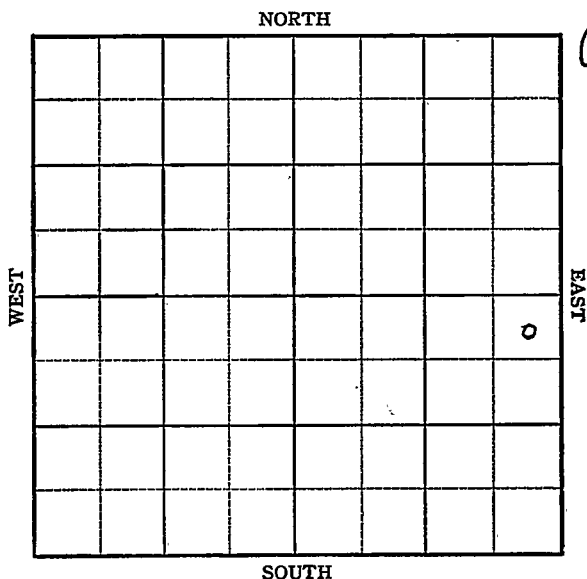


Section 7 Township 16 Range 10^{NE}Well No. #3 JezekCompany Alpine Oil & Royalty

Sec. 7 Twp. 16 R. 10W

Well No. #3 Jezek Farm

Alpine Oil & Royalty

Company

Quaker Drlg.

Contractor

Stoltenberg Pool


330' Ft. from N. Line

Ft. from S. Line

330' Ft. from E. Line

Ft. from W. Line

NE SE

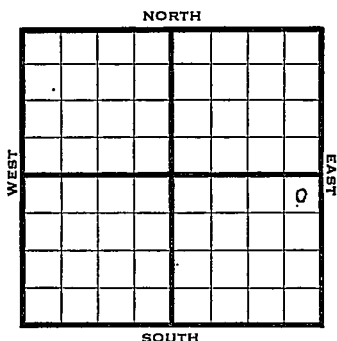

1949

Elev 1891'

REPORT

11/2

8" @ 347'

Anhy 700'

Drlg. 2933'

11/9

Whipstock at 2846'

11/23

TD 3370'

Arb. 3360'

5" @ 3361'

250 acid

Pump 25 Oil / 10% W Pot

42° Gr.

Comp

COMPLETED

Kansas

Map No. _____ Sec. 7 Twp. 16 R. 10WWell No. 3 Jezek

_____ Alpine Oil & Royalty _____ Company

_____ Quaker Drlg. _____ Contractor


NE SE

FIRST REPORT
SECTION PLAT330 Ft. from N. Line

_____ Ft. from S. Line

330 Ft. from E. Line

_____ Ft. from W. Line

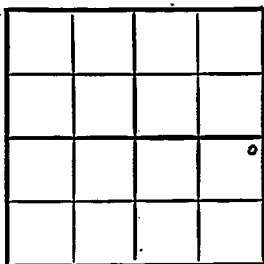

Ellsworth County

Location _____

Rig up _____

Drilling and Remarks:

8" @ 347

Anhy 700

drlg. 2933

RECORD

Cased _____ in., _____ ft.

Sand _____

Gas _____

Oil _____

Total Depth _____

PRODUCTION

1st 24 hrs. Nat. _____

1st 24 hrs. after shot _____

Gas _____ Cu. Ft.

Dry Hole _____

Abandoned _____

Date

NOV 2 1949 19

S. J. LEWIS

Scout

Kansas

Map No. _____ Sec. 7 Twp. 16 R. 10WWell No. 3 Jezek

Alpine Oil & Royalty Company

COMPLETE

Contractor

NE SE


E. 1891
SECTION PLAT330 Ft. from N. Line

_____ Ft. from S. Line

330 Ft. from E. Line

_____ Ft. from W. Line

Ellsworth County

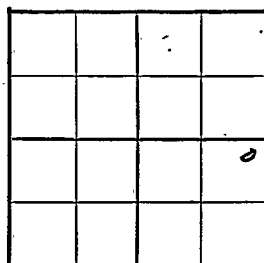

Location _____

Rig up _____

Drilling and Remarks:


RECORD

Cased _____ in., _____ ft.

Sand _____

Gas _____

Oil _____

Total Depth *3370*

PRODUCTION

1st 24 hrs. Nat. _____

1st 24 hrs. after shot _____

Gas _____ Cu. Ft.

Dry Hole _____

Abandoned _____

Date

NOV 23 1949

19

S. J. LEWIS

Scout